

Section 17 Township 14 Range 13W

Well No. #3 Rein "D"

Company Murfin Drlg.

NORTH

15

WEST

EAST

0

SOUTH

Russell

KANSAS
R. 13W ✓

Sec. 17 Twp. 14

Well No. #3 Rein "D" Farm

Murfin Drlg. Company

Murfin Drlg. - Contr. Contractor

Hall-Gurney Pool


Ft. from N. Line

990' Ft. from S. Line

Ft. from E. Line

330' Ft. from W. Line

NW SW SE

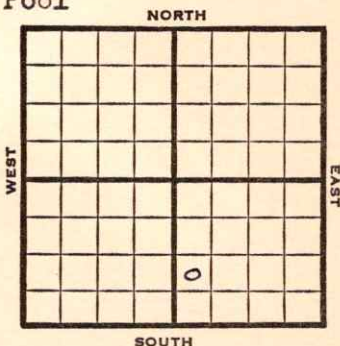

1950

Elev. 1861' REPORT

9/13

Cellar & Pits

11/15

Oil Well TD 2424
 10" @ 511' 8" @ 821'
 Anhy 835' Tarkio 2394'
 7" @ 2398' TD 2424'
 PB 2409' Comp. 30 BOPD

COMPLETED

