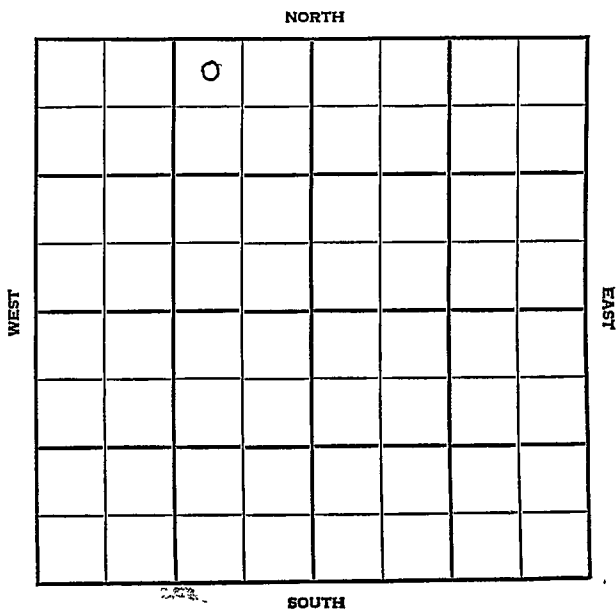


Section 23 Township 16 Range 11 WWell No. #2 TemplingCompany Rex & Morris & CRA

Barton

KANSAS

SEC.	TWP.	R.
23	16	14W

WELL NO.

#2 Templing

FARM

COMPANY

Rex & Morris & CRA

CONTRACTOR

Rex & Morris

Templing


_____ Ft. from N. Line

_____ Ft. from S. Line

_____ Ft. from E. Line

_____ Ft. from W. Line

NW NE NW

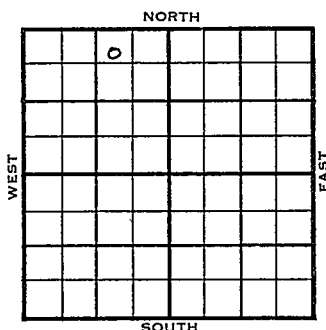

1955

ELEVATION

1952

REPORT

10/12

Comm 10-9-55
 8" @ 918 w/500
 Anh 912
 WOC

11-16

DST 3167-92 op 1 hr. rec 700' gas, 70'
 socm, 120' hocm, 950/30"
 DST 3218-52 op 1 hr. rec. 180' gas, 210'
 ocm, 30' mw 910/30"
 DST 3322-52 op 2 hrs. rec. 480' gas
 120' ocm, 180' ocs w 1060/30"
 5½" @ 3402/125
 DD 3409, 500 A
 S/ 2½ boph, FU 750' oil overnite
 S/ 3.60 boph 3 hrs.
 Comp. 114 bopd 6% wtr., TD 3409'
 Tops: Tp. 2860
 H. 3092
 Tr. 3107
 L. 3159
 C. 3381
 A 3400

COMPLETED

TOPS	DEPTH	LOG	DATUM	Loc. in Sec. _____
Anh.	912			NW NE NW
TP.				
H.				
Tr.				
Dg.				
BL.				
L.				Geol. _____
K.C.				Contr. _____
B.K.C.				Rex & Morris
Ce.				
C.				Pool _____
M.				Templing
M.				
K.				
Mz.				
Mq.				
V.				
S.				
S.				
A				
R.				
PE.				
G.				
TD.				

0

FIRST REPORT

OCT 12 '55

Date Comm. 10-9-55
8th @ 918/500 WOC

FIRST REPORT
OCT 12 '35

County Barton Elev. 1952
 Sec. 23 Twp. 16 Rge. 14W
 Company Rex & Morris & CRA
 Farm Name Templing No. 2

TOPS	DEPTH	LOG	DATUM	Loc. in Sec.
Anh.	912			NW NE NW
Top.	2860		908	
H.	3092		1140	
Tr.	3167		1155	
Dg.				
Bl.				
L.	3159		1207	Geol.
K.C.				Contr.
B.K.C.				Rex & Morris
Ce.				Pool
C.	3381		1429	Templing
M.				
M.				
K.				
Mz.				
Mq.				
V.				
S.				
S.				
A.	3400		1448	
R.				
PE.				
G.				
T.D.	3402			

Date Comm. 10-9-55 NOV 16 1955
 8" @ 918/500 DST 3167-92 open 1 hr.
 rec. 700' gas 70' socm 120' hocm
 950/30" DST 3218-52 open 1 hr.
 rec. 180' gas 210' ocm 30' mw
 910/30" DST 3322-52 open 2 hr.
 rec. 480' gas 120' ocm 180' ocsW
 1060/30" 5 $\frac{1}{2}$ " @ 3402/125 DD 3409
 500 A S/2 $\frac{1}{2}$ boph FU 750' oil overnite

COMPLETE

S/ 3.60 boph 3 hr. Comp. 114 bopd 6% wtr.

Scout Cards	✓
Land Small Map	
Land Wall Map	
Tracings	
France Map	
Pierce Map	
Misc.	

NOV 25 1955