


DX 78-1 Barton

KANSAS

Section 23 Township 16 Range 14W

Well No. #3 Templing

Company Rex & Morris & CRA

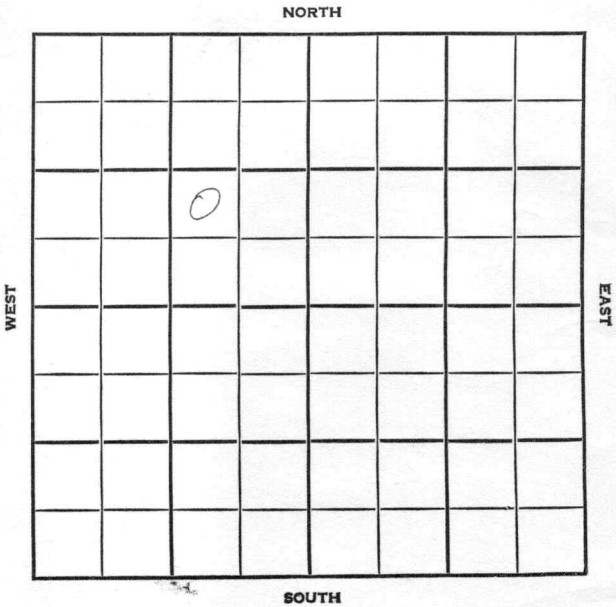

SEC. 23	TWP. 16	R. 14W
------------	------------	-----------

WELL NO.

#3 Templing

FARM

COMPANY

Rex & Morris & CRA

CONTRACTOR

Rex & Morris

Templing


FT. FROM N. LINE

FT. FROM S. LINE

FT. FROM E. LINE

FT. FROM W. LINE

NW SE NW

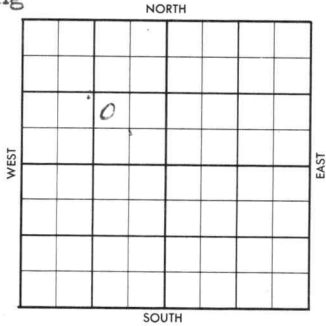

1956	ELEVATION 1951'	REPORT
------	--------------------	--------

6-6 Location

7-11

Comm. 6-6-56
 8" @ 904 w/455
 DST 3180-3200 op 1 hr, rec. 960' SW,
 BHP 980#
 DST 3320-60 op 1 hr, rec. 15' mud,
 BHP 0#.
 DST 3404-15 op 1 hr, rec. 55' HO&GCM,
 BHP 890#,
 5 1/2" @ 3404 w/75
 CO 3415
 B/ 28 GOPH, 4 hrs.
 S/ 9 1/4 BO, no/wtr., 5 hrs.
 S/ 23.1 BO, no/wtr. 8 hrs.
 P/ 100 BOPD, no/wtr.
 Tp. 2858'; H. 3090'/ Tr. 3104';
 L. 3157'; C. 3378'; A. 3402';
 TD 3415'

COMPLETED

County Barton Elev. 1951
 Sec. 23 Twp. 16 Rge. 14W
 Company Rex & Morris & CRA
 Farm Name Templing No. 3

Co.

TOPS	DEPTH	LOG	DATUM
Anh.			
Tp.	2859		
H.	3090		
Tr.	3104		
Dg.			
Bl.			
L.	3157		
K.C.			
B.K.C.			
Ce.			
C.	3378		
M.			
M.			
K.			
Mz.			
Mo.			
V.			
S.			
S.			
A.	3402		
R.			
Pe.			
G.			
TD.	3485		

Loc. in Sec.

NW SE NW

Geol.

Contr.

Rex & Morris

Pool

Templing

	0	
COMPLETE		

Use

No.

Date Comm.

JUL 1 1 1956

Location JUN 13 '56 - 6-6-56 8" 90°/45°

DST 3190 - 3200 JUN 20 '56 1 hr

rec 960' SW (550) BHP 980/

DST 3320 - 60 1 hr rec 15' Md

BHP 0 DST 3404 - 15 1 hr rec

55' HO 6 CM BHP 890 5 1/2

@ 3404 / 75 JUN 27 '56 CO 3415 - B

28 Goph 4 hrs 1/2 \$ 9 1/4 BO

no/w 5 hrs 1/2 \$ 23.1 BO no/w 5

8 hrs T & R

Sec.

T.

R.

23-16-14W NW SE NW

JUL 3 '56

JUL 11 '56

Ph P. 100 Bopd

no lwr

23-16-14 no ce no