

Russell

KANSAS

FORM 51 25M 3-49 PETROL

Section 13 Township 14 Range 13W

Well No. #1 Best

Company E. Wakefield

Wildcat

NORTH

W

WEST

EAST

		0					

SOUTH

Sec. 13 Twp. 14 R. 13W

Well No. #1 Best Farm _____

E. Wakefield Company _____


Wildcat (Wakefield, Contr **NORTH**)

330' Ft. from N. Line

_____ Ft. from S. Line

990' Ft. from E. Line

_____ Ft. from W. Line

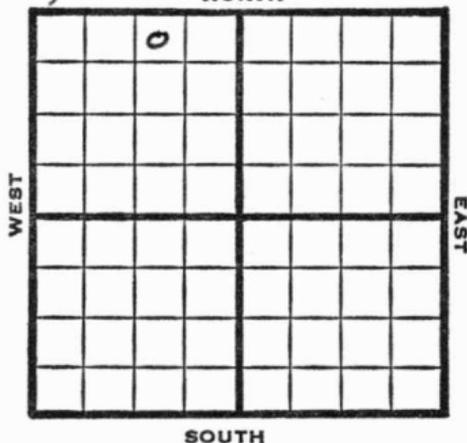

NW NE NW

SOUTH

1949 Elv. 1849' **REPORT**

11/30 Location

12/7 Drlg 135'

12/14 12½" @ 425'

10" @ 792'

Drlg. 850'

12/21 Drlg 2020'

12/28 2640 Run 8"

1950

1/25 12½" @ 425'

10" @ 792'

6" @ 3172'

5" @ 3100'

Arb 3337'

Perf 38/3037-45

Used 2000 gals acid

Small show oil

TD 3342'

D&A

ABANDONED

Map No. _____ Sec. 13 Twp. 14 R. 13W

Well No. 1 Best

E. Wakefield Company

Wakefield Contractor

NW NE NW

FIRST REPORT
 SECTION FLAT

?
330 Ft. from N. Line

_____ Ft. from S. Line

?
990 Ft. from E. Line

_____ Ft. from W. Line

	0	?	

Russell County

Location X

Rig up _____

Drilling and Remarks:

RECORD

Cased _____ in., _____ ft.

Sand _____

Gas _____

Oil _____

Total Depth _____

PRODUCTION

1st 24 hrs. Nat. _____

1st 24 hrs. after shot _____

Gas _____ Cu. Ft.

Dry Hole _____

Abandoned _____

Date

NOV 30 1949

19

S. J. LEWIS

Scout

per f. 38/3037-45

used 2000 gals acid
small show oil.

D & A.

SECTION PLAT

300 Ft. from N. Line
 Ft. from S. Line
 300 Ft. from E. Line
 Ft. from W. Line

RECORD

Scout Cards
Map Small Land
Map Well Land
Tracings
PRODUCTION
Map Pierce
Misc.
Cur.

JAN 30 1950

Drilling and Remarks:

Dry Hole
Abandoned

J. E. TYRA

JAN 25 1950

Map No. _____ Sec. 13 Twp. 14 R. 13WWell No. 1 BestE. Wakefield Company

Contractor

NW NE NW

E. 1849
SECTION PLAT330 Ft. from N. Line

_____ Ft. from S. Line

990 Ft. from E. Line

_____ Ft. from W. Line

Russell County



RECORD

Location _____

Cased _____ in., _____ ft.

Rig up _____

Sand _____

Drilling and Remarks:

Gas _____

12 1/2" @ 425'

Oil _____

10" @ 792Total Depth 33426" @ 31725" @ 3100

PRODUCTION

1st 24 hrs. Nat. _____

1st 24 hrs. after shot _____

Gas _____ Cu. Ft.

Dry Hole _____

Abandoned _____

and 3337(over)

Date


JAN 25 1950J. E. TYRA19

Scout

spot and
 measurement
 don't agree?
JK

Company _____
 Contactor _____

SECTION PLAT

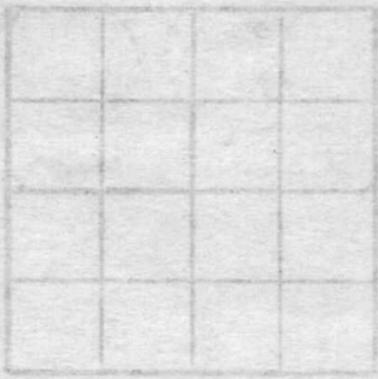

_____ Ft. from N. line
 _____ Ft. from S. line
 _____ Ft. from E. line
 _____ Ft. from W. line

RECORD
 _____ Cases
 _____ Sand
 _____ Gas
 _____ Oil
 _____ Total Depth

Location _____
 Dip _____
 Direction and Remarks _____

Scout Cards _____
 Land Small Map _____
 Land Wall Map _____
 Topographic _____
 Profile Map _____
 Plan Map _____

DEC 2 1949