


Section 7 Township 14 Range 13W **KANSAS**

Well No. #1 Crowe "B"

Company Jayhawk Drlg.

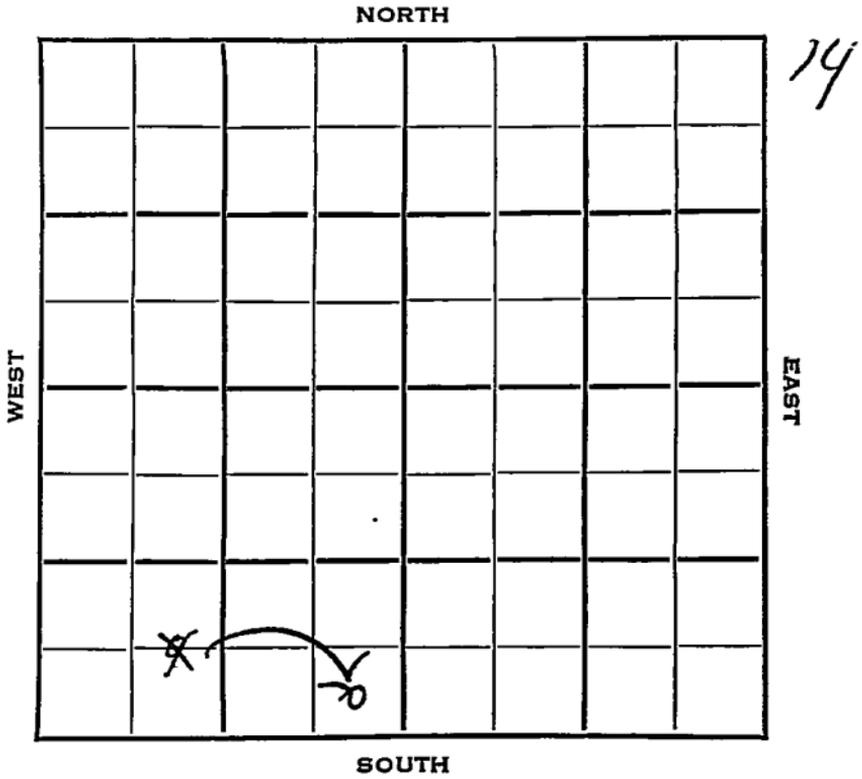

Russell KANSAS ✓

Sec. 7 Twp. 14 R. 13 W

Well No. # 1 Crowe "B" Farm

Jayhawk Drlg. Company

Jayhawk Contractor

Ft. from N. Line

330
~~660~~

Ft. from S. Line


330

Ft. from E. Line

~~990~~

Ft. from W. Line

~~G E L SW SW~~
SE SE SW

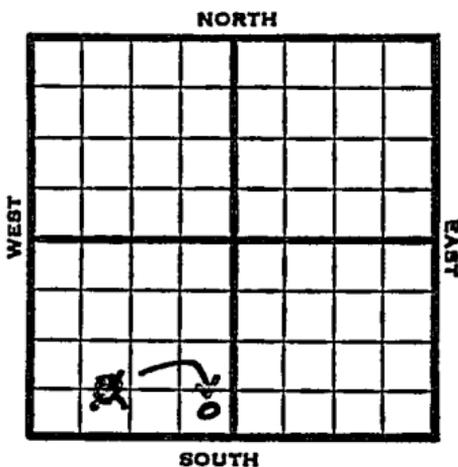

1953 Elev. 1842' REPORT

2/11 Spud 2-7-53
13" @ 270
Drlg. 415

2/19 Drilling
2/26 Drlg. 2315'

3/4 Spd 2-7-53
D&A
TD 2440
13" @ 270
Tarkio 2375
TD 2440
D&A

ABANDONED

Map No. _____ Sec. 7 Twp. 14 R. 13WWell No. 1 Crowe "B"Jayhawk Drlg. CompanyCORRECTION Contractor

SE SE SW

SECTION PLAT

_____ Ft. from N. Line

330 Ft. from S. Line330 Ft. from E. Line

_____ Ft. from W. Line

Russell County

Location _____

Rig up _____

Drilling and Remarks:

Reported

C E L SW SW

RECORD

Cased _____ in., _____ ft.

Sand _____

Gas _____

Oil _____

Total Depth _____

PRODUCTION

1st 24 hrs. Nat. _____

1st 24 hrs. after shot _____

Gas _____ Cu. Ft.

Dry Hole _____

Abandoned _____

Date

FEB 18 1953₁₉J. G. McGEHEE Scout

