


Section 18 Township 14 Range 13W

Well No. #2 C. W. Shaffer

Company Texas

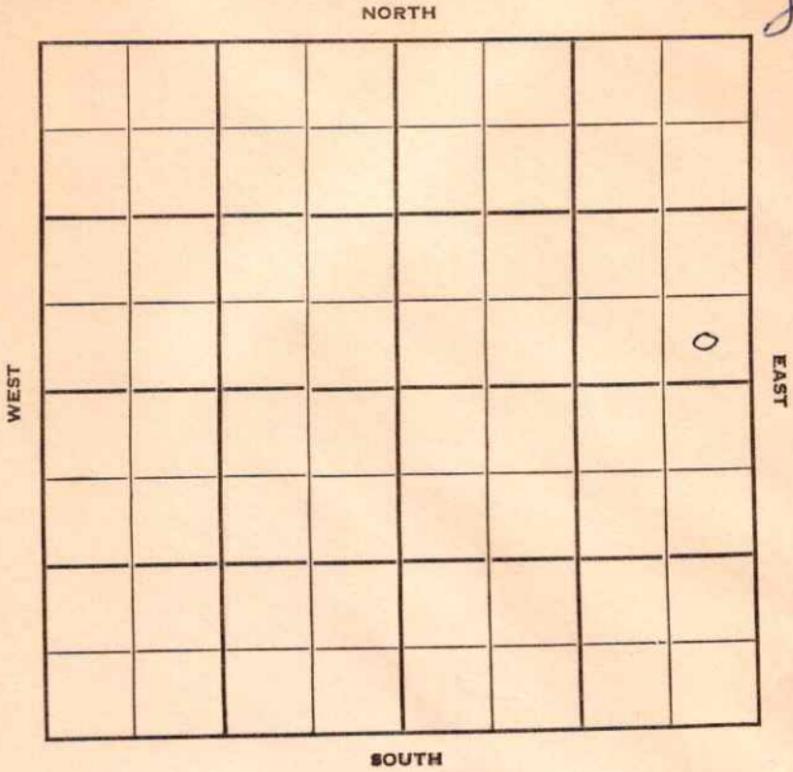

Russell

KANSAS ✓

Sec. 18 Twp. 14 R. 13W

Well No. #2 C. W. Shaffer Farm

Texas Company

Wakefield - Contr. Contractor

Hall Gurney


Ft. from N. Line

330' Ft. from S. Line

330' Ft. from E. Line

Ft. from W. Line

SE SE NE

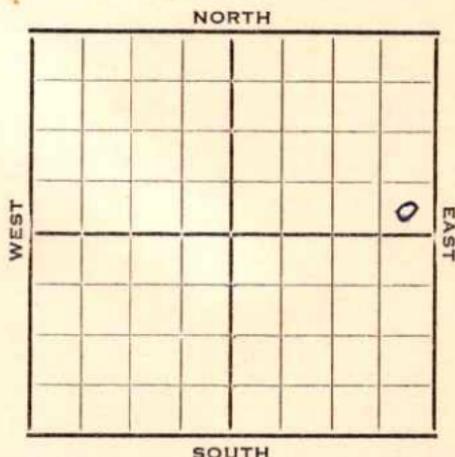


1952 Elev. 1828' REPORT

- 4/16 MICT
- 4/23 "
- 4/30 MICT
- 5/7 Drlg. 315'
- 5/14 13" @ 450' 10" @ 820  
Drlg. 990'
- 5/21 Drlg 2065'
- 5/28 Up Tarkio 2358-66' Low Tarkio 2379-81'  
7" @ 2380' WOC
- 6/11 CO DD 2386 TD SO PB 2383  
Strato-frac S/6 Boph PB 2375  
13/2360-64 SO&W CO 2383 8 BOPH
- 6/18 NR
- 6/25 Spud 5-3-52 Oil Well TD 2386'  
13" @ 450 10" @ 820'  
Tar. 2358-66 7" @ 2380  
TD 2386 B/ 13 goph PB 2383  
Stratofrac S/ 6 boph PB 2375  
13/ 2360-64 B 23 go tr. wtr. ph  
Stratofrac S/ 2 boph CO to 2383  
S/ 8 boph  
Comp. 80 bopd 5 bw

COMPLETED

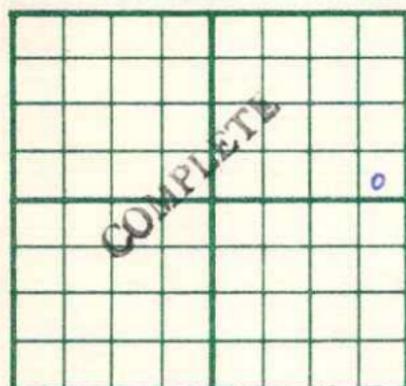

County Russell State KansasSec. 18 (Bk.  
Twps.) 14 (Sur.  
Rge.) 13W Map No.Operator Texas CompanyWell No. 2 Farm C. W. ShafferElev. 1828 Location SE SE NE330 Ft. From S Line NE330 Ft. From E Line Quarter

1st. Report

JUN 25 1952

Completion

Remarks Hall-Gurney PoolWakefield - Contr.Spudding Date 5-3-52Drlg. Data Oil well TD 238613" @ 450 10" @ 820 Tarkio 2358-667" @ 2380 TD 2386 B/ 13 goph PB 2383stratofrac S/ 6 boph PB 2375 13/ 2360-64 B/ 23 go tr. water ph stratofracS/ 2 boph CO to 2383 S/ 8 bophComp. 80 bopd 5 bw