


Section 18 Township 14 Range 13W

Well No. #3 Dale

Company Murfin Drlg.

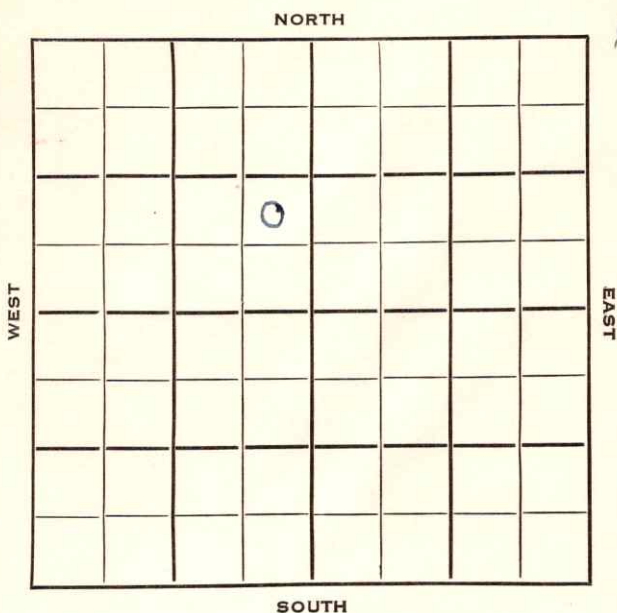

Sec. 18 Twp. 14 R. 13W

Well No. #3 Dale _____ Farm _____

Murfin Drlg. Company _____

Murfin Drlg. Contractor _____

Hall-Gurney Pool


_____ Ft. from N. Line

990 Ft. from S. Line

330 Ft. from E. Line

_____ Ft. from W. Line

NE SE NW

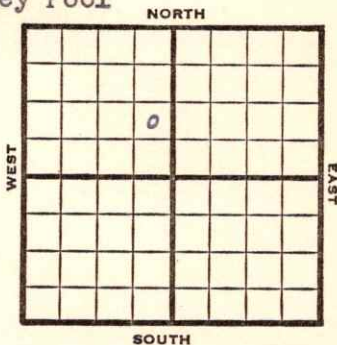

1953

Elev. 1825'

REPORT

5/6 Location

5/21 "

5/28 "

6/3 "

6/10 "

6/24 13" @ 360
Drlg. 460'

7/1 10" @ 485
Anhy 807

8" @ 818
Drlg. 1265

7/8 Drlg 2245'

7/22 NR

7/29 Spud 6-21-53

D & A TD 2415 13" @ 360

10" @ 485 **Anhy 807** 8" @ 818

Tarkio 2364 TD 2415 7" @ 2362

PB 2367 Hydro. D & A

ABANDONED

