



Russell KANSAS


SEC.	TWP.	R.
10	14	13W

WELL NO  
2 Lewis FARM

COMPANY  
Sam Kessler & Alex Schmidt

CONTRACTOR  
Duke & Wood-Contr.

\_\_\_\_\_ Ft. from N. Line  
330 \_\_\_\_\_ Ft. from S. Line  
\_\_\_\_\_ Ft. from E. Line  
990 \_\_\_\_\_ Ft. from W. Line

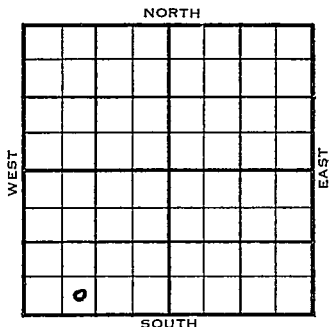

SE SW SW

1954	ELEVATION 1817'	REPORT
------	--------------------	--------

6/15 Loc.  
6/23 8" @ 235'  
Drlg. 2207'  
6/30 Tarkio 2356'  
RTD 2400'  
5" @ 2400'  
7/7 28/2362-64, S/wtr.  
8/4 Spud 6-17-54 - Oil Well  
TD 2400'  
8" @ 235'  
Tarkio 2356'  
TD 2400'  
5" @ 2400'  
28/2362-64  
S/wtr, frac  
S/7 boph 60% wtr.  
Comp. 25 bopd 50% wtr.

COMPLETED



