

KANSAS

Section 12 Township 15 Range 11-W

Well No. #7 Tittle "A"

Company Cities Service

NORTH

0							

WEST

EAST

SOUTH

KANSAS

Russell



Sec. 12 Twp. 15 R. 14W

Well No. #7 Tittle "A" Farm

Cities Service Company

Trapp Pool


990' Ft. from N. Line

_____ Ft. from S. Line

_____ Ft. from E. Line

330' Ft. from W. Line

SW NW NW

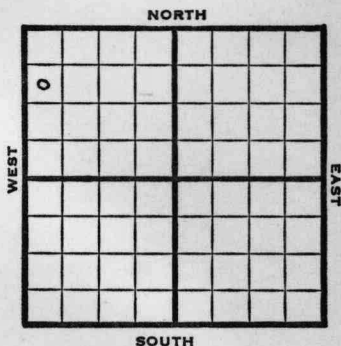

1948

Eli 1872' REPORT

- 7/8 Location
- 7/14 "
- 7/21 Surface hole
- 7/28 8" @ 526'
- Drlg 2783'
- 8/4 Arbuckle 3312-17'
- TD 3317'
- 5" @ 3314'
- 8/11 Lansing 3057'
- 8/18 500 acid
- Pump 220 bbls oil 20 hrs.
- 8/25 Lansing 3057'
- Arb. 3312'
- 5" @ 3314'
- TD 3317'
- 500 acid
- Echo Pot 930' oil
- 40⁰ Gr.
- Comp
- COMPLETED**

Map No. _____ Sec. 12 Twp. 15 R. 14W

Well No. 7 Tittle "A "

Cities Service _____ Company

FIRST REPORT _____ Contractor

SW NW NW

SECTION PLAT

o			

990 Ft. from N. Line

_____ Ft. from S. Line

_____ Ft. from E. Line

330 Ft. from W. Line

Russell County

Location X

Rig up _____

Drilling and Remarks:

RECORD

Cased _____ in., _____ ft.

Sand _____

Gas _____

Oil _____

Total Depth _____

PRODUCTION

1st 24 hrs. Nat. _____

1st 24 hrs. after shot _____

Gas _____ Cu. Ft.

Dry Hole _____

Abandoned _____

Date

JUL 8 1948 19

S. J. LEWIS Scout

Russell

County

Kansas

State

Map No.

73

Sec.

12

Twp.

15

R. 14W

Well No.

7 Tittle "A"

Cities Service

Company

COMPLETE

Contractor

SW NW NW

E11872
SECTION PLAT

990 Ft. from N. Line

Ft. from S. Line

Ft. from E. Line

330 Ft. from W. Line

Trapp Pool

Remarks:

Lane 3057

Cr + 3312


5" e 3314

713317

500 acid

Ech + 930 oil

409 Sw

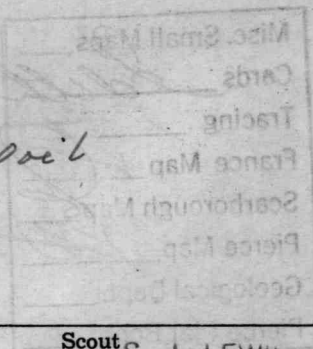

Date

AUG 23 1948

Scout

S. J. LEWIS