


Section 24 Township 16 Range 14-W

Well No. #2, Seimsen

Company Derby Oil Company

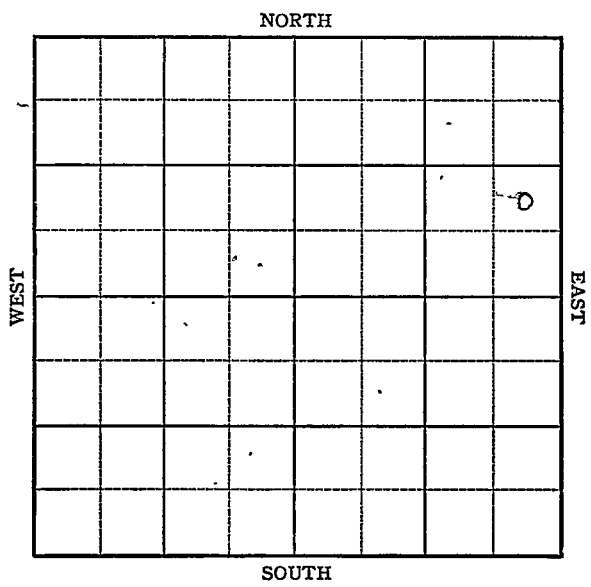

Sec. 24 Twp. 16 R. 14W

Well No. #2 Seimsen Farm

Derby Oil Company


Susank

Ft. from N. Line

990 Ft. from S. Line

330 Ft. from E. Line

Ft. from W. Line

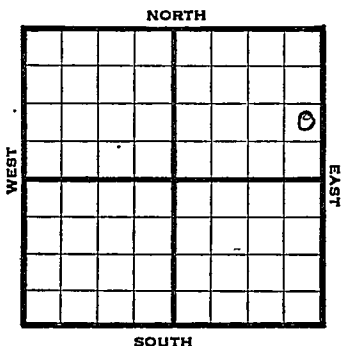

NE SE NE

1946 Elev. 1918' REPORT

8/28 Location

9/5 8" @ 624'
Drlg 1967a

9/10 Lans 3134
Drlg 3182'

9/18 Arb 3349'
5" @ 3350'
TD3354-500 acid
Swb 16 oil PH

9/24 TD 3363 $\frac{1}{2}$
2500 acid
swb 37 oil PH 3 hrs

10/1 " " "

10/8 " " "

10/15 " " "

10/22 " " "

10/30 Arb 3349'
5" @ 3350'
2000 Acid
Pump 660 POT
TD 3363 $\frac{1}{2}$
Grav. 39

COMPLETED

