



Russell

KANSAS

Sec. 18 Twp. 14 R. 13 W ✓

Well No. # 1 Mohl Farm \_\_\_\_\_

Texas Company Company

Murfin Drlg. Contractor


\_\_\_\_\_ Ft. from N. Line

330 Ft. from S. Line

\_\_\_\_\_ Ft. from E. Line

330 Ft. from W. Line

SW SW SE

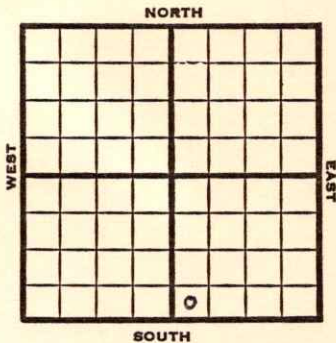

1951

**Elev. 1782'** REPORT

3/21

Location

5/29

Spud 4-4-51

Oil Well TD 2337

15" @ 24 13" @ 325 10" @ 425

8" @ 748 **Tarkio 2298**

7" @ 2320 TD 2337

S/28 boph SP 2325

Hydrafrac S/100 bo 11½ hr

Comp . 76 bopd

**COMPLETED**



