
FORM 51 5M 6-46 PETROL KANSAS Barton county

Section 24 Township 16 Range 14-W

Well No. #3, Siemsen

Company Derby

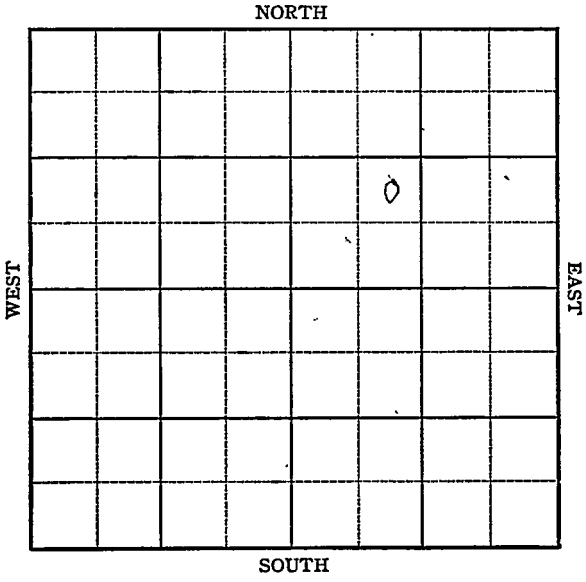

O. W. P. B.

FORM 252-A
5M 6-46 PETROL

KANSAS

Barton County

Sec. 24 Twp. 16 R. 14W

Well No. #3 Siemsen Farm

Derby Company

Susank


Ft. from N. Line

990 Ft. from S. Line

Ft. from E. Line

990 Ft. from W. Line

NE SW NE

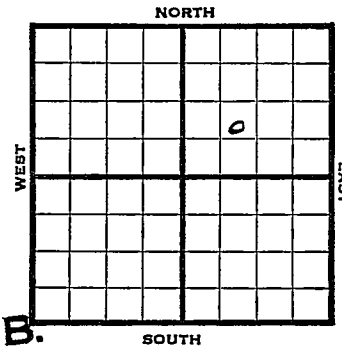

O. W. P. B.

1946 1926 REPORT

9/25 8" @ 624'
Drlg 1500'
10/1 Drlg 2963'
10/8 Lans 3134'
Arb 3367-70 TD
5" @ 3368 RUST
10/15 " " "
10/22 TD 3384-500 acid
Swb 13 oil PH 8 hrs
10/29 " "
11/6 " "
11/12 " "
11/20 Arb 3367'
5" @ 3368'
TD 3384'
500 Acid
Pump 204 Oil plus 20% W Pot
39 Grav.

COMPLETED

1950 O. W. P. B.

8/2 Lans 3134.
SP 3100
24/2996-3004
B/20 bo 15 bw
45 min
500 acid
P/7 bo trace wtr
Comp 30 bopd
Completed

FIRST REPORT COMPLETED

FORM 26 200 BKS. 2-44 PETROL

KANSAS Kansas Pool Name Susank

Map No. 73 Sec. 24 Twp. 16 R. 14W


Well No. 3 Siemsen

Derby Company

FIRST REPORT Contractor

NE SW NE

SECTION PLAT

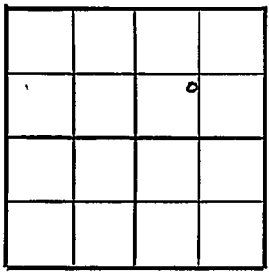

____ Ft. from N. Line

990 Ft. from S. Line

____ Ft. from E. Line

990 Ft. from W. Line

Barton County

Location

Rig up

Drilling and Remarks:

8"@ 624'

1500'

RECORD

Cased ____ in., ____ ft.

Sand

Gas

Oil

Total Depth

PRODUCTION

1st 24 hrs. Nat.

1st 24 hrs. after shot

Gas ____ Cu. Ft.

Dry Hole

Abandoned

Date

SEP 25 1946 19 S. J. LEWIS Scout

Form 26 200 Bks. 10-46 Petrol

KANSAS Susank Pool

Kansas

Map No. 73 Sec. 24 Twp. 16 R. 14W

Well No. 3 Siemsen


Derby Company

COMPLETED Contractor

NE SW NE

Feb 1, 1926

SECTION PLAT

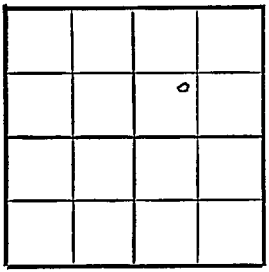

____ Ft. from N. Line

990 Ft. from S. Line

____ Ft. from E. Line

990 Ft. from W. Line

Barton County

Location

Rig up

Drilling and Remarks:

Cr 3867

T.D. 3885.

300 acid

Pump 20 # oil +

20 # W BS

892 Gr

RECORD

Cased ____ in., ____ ft.

Sand

Gas

Oil

Total Depth 3884

PRODUCTION

1st 24 hrs. Nat.

1st 24 hrs. after shot.

Gas ____ Cu. Ft.

Dry Hole

Abandoned

Date

NOV 20 1946 19

S. J. LEWIS Scout

Form 26 200 Bks. 11-49 Petrol

Kansas

OWPB

Map No. _____ Sec. 24 Twp. 16 R. 14W

Well No. 3 Seimsen


Derby Oil Company

Contractor

NE SW NE

El. 1926

SECTION PLAT

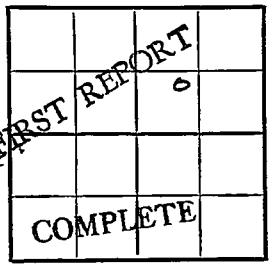

_____ Ft. from N. Line

990 Ft. from S. Line

_____ Ft. from E. Line

990 Ft. from W. Line

Barton County

Location _____

Rig up _____

Drilling and Remarks:

Lans. 3134

SP 3100

24/ 2996-3004

B/ 20 go 15 gw

45 min.

500 acid

P/ 7 bo trace water

Comp. 30 bopd

Date

AUG 2 1950

RECORD

Cased _____ in., _____ ft.

Sand _____

Gas _____

Oil _____

Total Depth _____

PRODUCTION

1st 24 hrs. Nat. _____

1st 24 hrs. after shot _____

Gas _____ Cu. Ft.

Dry Hole _____

Abandoned _____

19 J. E. TYRA Scout