

Section 14 Township 14 Range 13 WWell No. # 1 JonesCompany Duke & Wood

NORTH

13

0							

SOUTH

WEST

EAST

Russell		KANSAS	
SEC.	14	TWP.	14
		R.	13W

WELL NO. #1 Jones

FARM

COMPANY Duke & Wood

CONTRACTOR Duke & Wood

Hall-Gurney Pool

Ft. from N. Line


330

Ft. from S. Line

Ft. from E. Line

330 Ft. from W. Line

SW SW SW

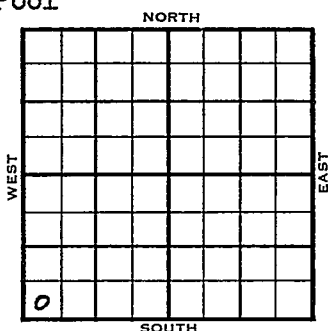

	ELEVATION	REPORT
1953	1817'	

10/14	Cellar & Pits
10/21	C&P
10/28	"
11/4	"
11/11	"
11/18	NR
12/9	Spud 11-2-53 D & A TD 2380 8" @ 246 Tarkio 2338 2nd Tarkio 2387 TD 2380 5" @ 2379 CO to 2360 18/2319-21 wtr. Sq. perf CO to 2360 Hydrofrac. S/1 BO 11 BWPH D & A

ABANDONED

County Russell State Kansas

Sec. 14 (Blk. Twp.) 14 (Sur. Rge.) 13W Map No.

Operator **Duke & Wood**

Well No. 1 Farm Jones

Elev.	Location	SW	SW	SW
-------	----------	----	----	----

0

FIRST REPORT

330 Ft. From S Line SW

330 Ft. From W Line Quarter

1st. Report OCT 14 1953

Completion

Remarks

Duke & Wood - Contr.

Spudding Date _____

Drig. Data Hall-Gurney Pool

Cellar & pits

County Russell State Kansas

Sec. 14 (Blk. Twp.) 14 (Sur. Rge.) 13^W Map No.

Operator Duke & Wood

Well No. 1 Farm Jones "C"

Elev.	1817	Location	SW SW SW
-------	------	----------	----------

ABANDONNEE

330 Ft. From S Line SW

330 Ft. From W Line Quarter

1st. Report

Completion DEC 9 1953

Remarks Hall-Gurney Pool

Duke & Wood - Contr.

Spudding Date 11-2-53

Drig. Data D & A TD 2380

8" @ 246 Tarkio 2338 2nd Tarkio 2387

TD 2380 5" @ 2379 . CO to 2360

18/ 2319-21 wtr. sq. perf. CO to 2360

Hydrofrac S/ 1 bo 11 bwph

D & A

J. G. McGEHEE