


Section 24 Township 16 Range 14-W

Well No. #4, - Siemsen

Company Derby Oil Company

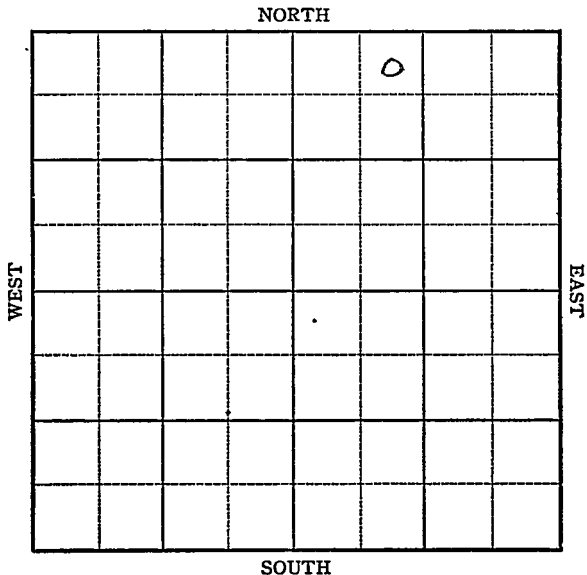

Sec. 24 Twp. 16 R. 14W

Well No. #1 Siemsen Farm


Derby Oil Company

330 Ft. from N. Line

\_\_\_\_\_ Ft. from S. Line

\_\_\_\_\_ Ft. from E. Line

990 Ft. from W. Line

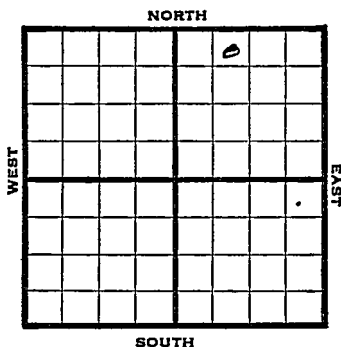

NE NW NE

1946 Elev. 1925 REPORT

11/6	Location
11/12	"
11/20	8" @ 655' Drlg 1546'
11/27	Drlg 3040'
12/3	Lans 3139' Arb 3357-58 TD 5" @ 3856', RUST
12/10	TD 3368-2000 acid Swb 12 oil PH 7 hrs.
12/17	" " "
1947	
1/4	TD 3368' 2000 acid, swb 12 oil PH 7 hrs
1/8	" " "
1/15	Arb 3357' 5" @ 3356' TD 3368' 2000 Acid Pump 220 oil t 30% W Pot 39-GR.

**COMPLETED**

Map No. 73 Sec. 24 Twp. 16 R. 14W

Well No. 4 Siemsen

Derby Oil Company

FIRST REPORT Contractor

NE NW NE

SECTION PLAT

330 Ft. from N. Line

\_\_\_\_\_ Ft. from S. Line

\_\_\_\_\_ Ft. from E. Line

990 Ft. from W. Line

		0	

Barton County

Location X

Rig up \_\_\_\_\_

Drilling and Remarks:

RECORD

Cased \_\_\_\_\_ in., \_\_\_\_\_ ft.

Sand \_\_\_\_\_

Gas \_\_\_\_\_

Oil \_\_\_\_\_

Total Depth \_\_\_\_\_

PRODUCTION

1st 24 hrs. Nat. \_\_\_\_\_

1st 24 hrs. after shot \_\_\_\_\_

Gas \_\_\_\_\_ Cu. Ft.

Dry Hole \_\_\_\_\_

Abandoned \_\_\_\_\_

Date

NOV 6 1946 19

S. J. LEWIS Scout

Map No. 73 Sec. 24 Twp. 16 R. 14WWell No. 4 Siemsen

Derby Oil

Company

COMPLETE

Contractor

NE NW NE

E 11925  
SECTION PLAT330 Ft. from N. Line

\_\_\_\_\_ Ft. from S. Line

\_\_\_\_\_ Ft. from E. Line

990 Ft. from W. Line

		0	

Barton County

Location \_\_\_\_\_

Rig up \_\_\_\_\_

Drilling and Remarks:

Ar 48857  
 51103306  
 2000 acid  
 Pump 220 oil +  
 30% oil  
 89 1/2

## RECORD

Cased \_\_\_\_\_ in., \_\_\_\_\_ ft.

Sand \_\_\_\_\_

Gas \_\_\_\_\_

Oil \_\_\_\_\_

Total Depth 2365

## PRODUCTION

1st 24 hrs. Nat. \_\_\_\_\_

1st 24 hrs. after shot \_\_\_\_\_

Gas \_\_\_\_\_ Cu. Ft.

Dry Hole \_\_\_\_\_

Abandoned \_\_\_\_\_

Date

JAN 15 1947

19

S. I. LEWIS Scout