

Cowley
34

KANSAS 3E ✓

4

Sec. _____ Twp. _____ R. _____

#1 Quinn

Well No. _____ Farm _____

Aladdin Petr.

Company _____

Crowe Drlg.

Contractor _____

Wildcat


_____ Ft. from N. Line

330 Ft. from S. Line

_____ Ft. from E. Line

330 Ft. from W. Line

SW SW SE

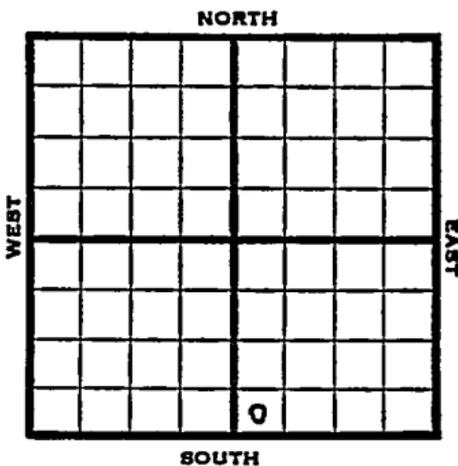

1952

Elev. 1101' REPORT

12/17 RUR

1953

1/28

Spud 12-19-52 Oil well TD 3308'

8" @ 130 Bart. 3296' TD 3308'

5" @ 3299

Schl. Tops: Layton 2610' KC 2786'

Marm. 2993' GO to 3308' PB 3305'

Hydro.

Comp. 25 BOPD

COMPLETED

County Cowley State Kansas

Sec. 4 (Blk. Twp.) 34 (Sur. Rge.) 3E Map No.

Operator Aladdin Pet.

Well No. 1 Farm Quinn

Elev. Location SW SW SE

330 Ft. From S Line SE
330 Ft. From W Line Quarter

Ist. Report DEC 17 1952

Completion _____

Remarks Crowe Drlg. - Contr.

Spudding Date _____

Drlg. Data Wildcat

RUR


County Cowley State Kansas

Sec. 4 (Blk. Twp.) 34 (Sur. Rge.) 3E Map No.

Operator Aladdin Pet.

Well No. 1 Farm Quinn

Elev. 1101 Location SW SW SE

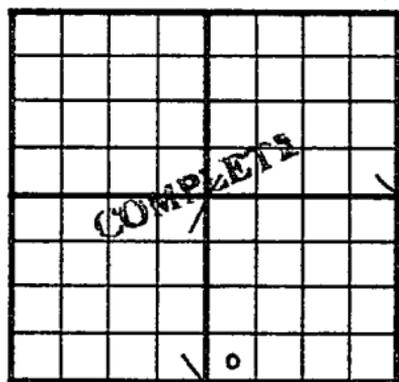

330 Ft. From S Line SE

330 Ft. From W Line Quarter

1st. Report

Completion JAN 28 1953

Remarks Wildcat

Crowe Drlg. - Contr.

Spudding Date 12-19-52

Drlg. Data Oil well TD 3308

8" @ 130 Bart. 3296 TD 3308

5" @ 3299 SCHLUMBERGER TOPS

Layton 2610 KC 2786 Marm. 2993

CO to 3308 PB 3305 Hydro.

Comp. 25 bopd

J. G. McGEHEE