


Section 5 Township 34 Range 3-E

Well Number 1 Brewer

Company Shawver

15

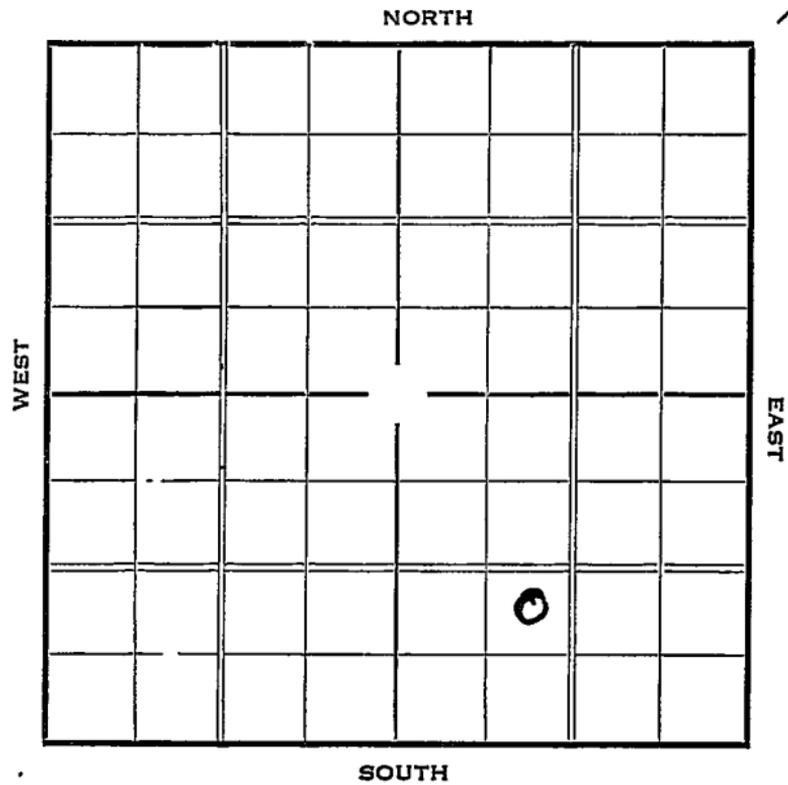

Sec. 5 Twp. 34 R. 3-E

Well No. #1 Brewer Farm
Shawver Company


_____ Ft. from N. Line

990 Ft. from S. Line

_____ Ft. from E. Line

990 Ft. from W. Line

Elev. 1098

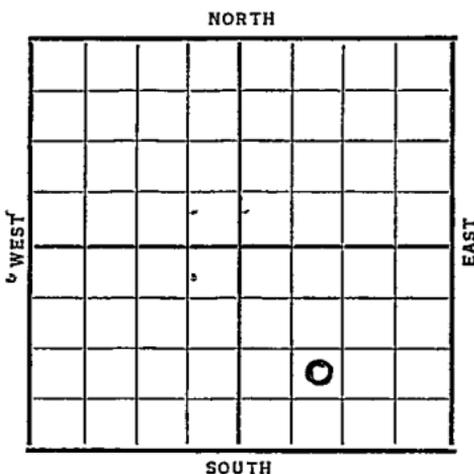

Date	REPORT
1937	
3/24	Rig
4/2	10" @ 125' WOC
4/8	Drlg. 2236'
4/16	Drlg. 3237'.
4/23	6" @ 3274'. Top Bart. Sd.
4/30	Chat 3322'. H.F.W. 3352-58' TD
	P.B. 3323'. Shot 10 qts.
5/7	Clean out.
5/14	" "
5/21	T.D. 3332'. Shot 80 qts.
	Est. 10 bbls. per day.

OVER

1937

5/26

Chat 3321'.

T.D. 3358'.

P.B. 3332'.

Shot with 80 qts.

Pot. 8 bbls. oil, flowing.

COMPLETED

KANSAS *Dowley*

Map No. 1 Sec. 5 Twp. 34 R. 35

Well No. 1 Brewer

Shawver Company

Contractor

SECTION PLAT

			0

_____ Ft. from N. Line

990 Ft. from S. Line

_____ Ft. from E. Line

990 Ft. from W. Line

FIRST REPORT

Location _____

Rig up _____

Drilling and Remarks:

Rig

RECORD

Cased _____ in., _____ ft.

Sand _____

Gas _____

Oil _____

Total Depth _____

PRODUCTION

1st 24 hrs. Nat. _____

1st 24 hrs. after shot _____

Gas _____ Cu. Ft.

Dry Hole _____

Abandoned _____

Date

MAR 24 1937 19

S. J. LEWIS Scout

Cowley **KANSAS**Map No. 1 Sec. 5 Twp. 34 R. 3EWell No. 1-BrewerShawver Company

Contractor

COMPLETED**SECTION PLAT**

		0	

_____ Ft. from N. Line

990 Ft. from S. Line

_____ Ft. from E. Line

990 Ft. from W. Line

Location _____

Rig up _____

Drilling and Remarks:

P.B. 3332Shot w/80 gts...Put 8 oilflowing**RECORD**

Cased _____ in., _____ ft.

Sand Chat 3321

Gas _____

Oil _____

Total Depth 3358**PRODUCTION**

1st 24 hrs. Nat. _____

1st 24 hrs. after shot _____

Gas _____ Cu. Ft.

Dry Hole _____

Abandoned _____

Date

MAY 26 1937 19H. D. Hatfield

Scout