


Section 5 Township 34 Range 3E

Well No. #1 Brewer "A"

Company C R A

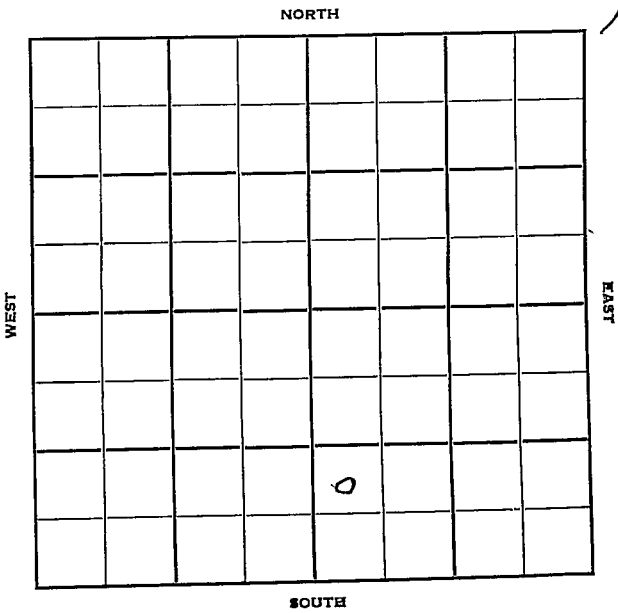

Cowley

KANSAS

Sec. 5 Twp. 34 R. 3E ✓

Well No. #4 Brewer "A" Farm

C R A Company

Uhl Drlg. Contractor


_____ Ft. from N. Line

990 Ft. from S. Line

_____ Ft. from E. Line

330 Ft. from W. Line

NW SW SE

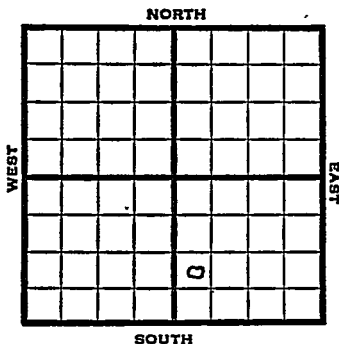

1952 Elev. 1088' REPORT

10/8

Drlg.

Spud 10-7-52

11/5

Spud 10-7-52

Oil Well TD 3306'

Layton 2614

KC 2791

Batt. 3292

TD 3306 5" @ 3293'

PB 3304 3-Hydro. S/ 126 bo

24 hr.

Comp. 65 bopd 8 bw

COMPLETED

