

KANSAS


Barton

FORM SI 5M BRIX

Section 25 Township 16 Range 14W

Well No. #1, Chal

Company Phillips Pet.

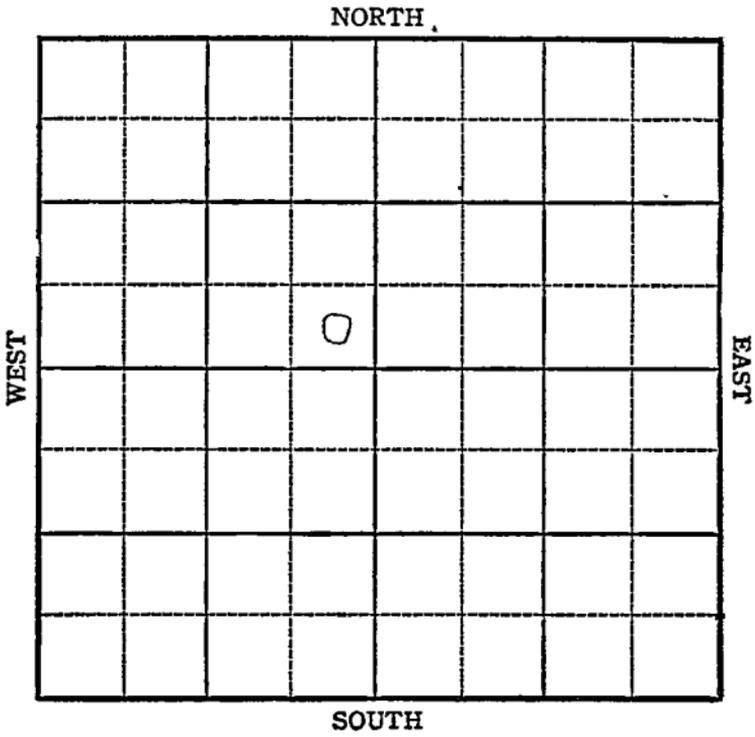

Sec. 25 Twp. 16 R. 14W

Well No. #1 Chal Farm _____
Phillips Company _____


Barrett

_____ Ft. from N. Line

330 Ft. from S. Line

330 Ft. from E. Line

_____ Ft. from W. Line

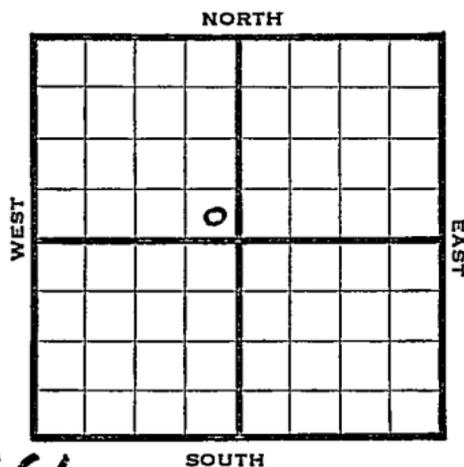

Elev. 1961

1944

REPORT

5/24

Location

5/31

Rotary

6/7

8" @ 643
Drlg. 1793'

6/15

Drlg. 3108

6/21

Heetner 3094
Dodge 3171
Lans 3185 SO 3268-75
Arb. 3401
TD 3421
So 5" @ 3404 RUST

6/28

TD 3440 500 acid
15 gals oil per hr

7/19

5" @ 3404
Arb. 3401
TD 3441 $\frac{1}{2}$
1000 acid.
Pump 140 Pot.
Gravity 36.0

COMPLETED

Pool Name BarrettMap No. 7 Sec. 25 Twp. 16 R. 14WWell No. 1 ChalPhillips CompanyCOMPLETED Contractor

SE NW

SECTION PLAT

		6	

_____ Ft. from N. Line

330 Ft. from S. Line330 Ft. from E. Line

_____ Ft. from W. Line

Barton County

Location _____

Rig up _____

Drilling and Remarks:

Art 3401
5" C3404
1000000'
Pump 140 P

362/2

RECORD

Cased _____ in., _____ ft.

Sand _____

Gas _____

Oil _____

Total Depth 3441 1/2

PRODUCTION

1st 24 hrs. Nat. _____

1st 24 hrs. after shot _____

Gas _____ Cu. Ft.

Dry Hole _____

Abandoned _____

Date

JUL 1 9 1944 19

S. J. LEWIS Scout