


Section 25 Township 16 Range 14 ^{KANSAS} W

Well No. # 1 Chalaupka

Company Anschultz

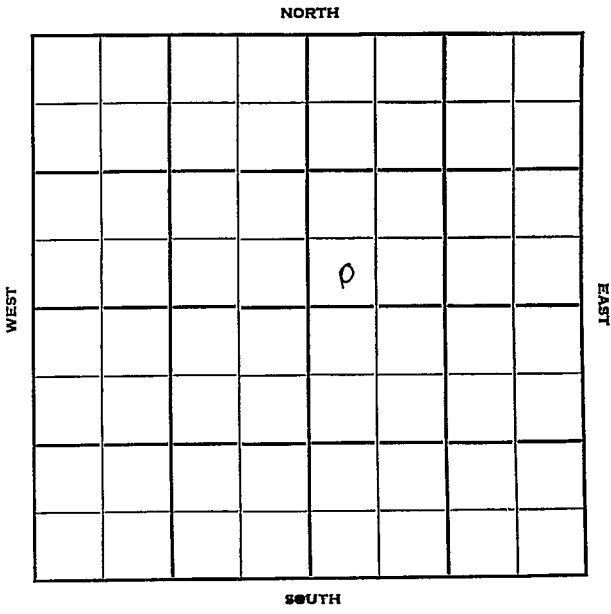


Barton

KANSAS

Sec. 25 Twp. 16 R. 14WWell No. #1 Chalaupka FarmAnschultz CompanyPeel Contractor Ft. from N. Line330 Ft. from S. Line Ft. from E. Line330 Ft. from W. Line

SW SW NE

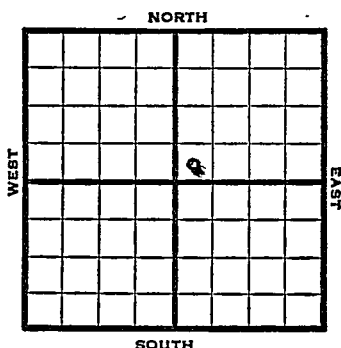

1951 Elev. 1966'


REPORT

11/7 Location

1952
1/30

Spud 11-9-51
Oil Well TD 3468
8" @ 560 Anhy 945 Heeb. 3118
Lans. 3192
DST 3204-40 open $1\frac{1}{2}$ hr. rec. 780' SW
DST 3371-3401 open $1\frac{1}{2}$ hr. rec. 60' ocm
Cong. 3417 Arb. 3420-30
5" @ 3424 TD 3439 5000 A SSO
DD 3453 B/ $2\frac{1}{2}$ goph 1000 A S/ $1\frac{1}{2}$
boph 1 bwph DD 3468 B/ 1 bw
1 go PB 3385 36/ 3373-79 500 A
S/ 1 boph 5 hr. 2000 A S/ 1 boph
3500 A Hydro. S/ $3/4$ boph 36 hr.
Comp. 10 bopd
D&A

COMPLETED

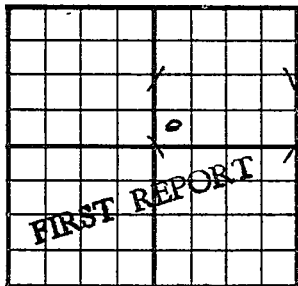County Barton State KansasSec. 25 (Blk. Twp.) 16 (Sur. Rge.) 14W Map No.Operator AnschultzWell No. 1 Farm ChalaupkaElev. Location SW SW NE330 Ft. From S Line NE330 Ft. From W Line Quarter1st. Report NOV 7 1951

Completion

Remarks

Peel - Contr.

Spudding Date

Drlg. Data

Location


J. E. TYRA

County Barton State Kansas
 Sec. 25 (Blk.) 16 (Sur.) 14W Map No.

Operator Anschutz Drlg.

Well No. 1 Farm Chalaupka

Elev. 1966 Location SW SW NE

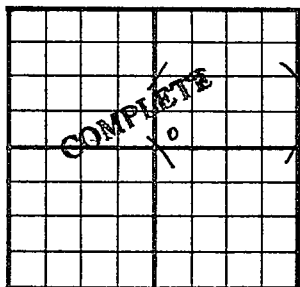

330 Ft. From S Line NE

330 Ft. From W Line Quarter

1st. Report

Completion JAN 30 1957

Remarks Peach pool

Spudding Date 11-9-51

Drilg. Data Oil well TD 3468

8" @ 560 Anhy 945 Heeb. 3118

Lans. 3192 DST 3204-40 open 1½ hr.

Rec. 780' sw DST 3371-3401 open 1½ hr.

Rec. 60' ocm Cong. 3417 Arb. 3420-30

5" @ 3424 TD 3439 500 A SSO

DD 3453 B/ 2½ goph 1000 A S/ 1½ boph

1 bwph DD 3468 B/ 1 bw 1 go

PB 3385 36/ 3373-79 500 A S/ 1 boph

5 hr. 2000 A S/ 1 boph 3500 A

Hydro. S/ 3/4 boph 36 hr.

Comp. 10 bopd

J. G. McGEHEE