

Cowley
34

KANSAS ✓
3E

4

Sec. _____ Twp. _____ R. _____

#2 Boggs

Well No. _____ Farm _____

Capitt Drlg.

Company _____

Contractor _____


_____ Ft. from N. Line

330 Ft. from S. Line

330 Ft. from E. Line

_____ Ft. from W. Line

SE SE SW

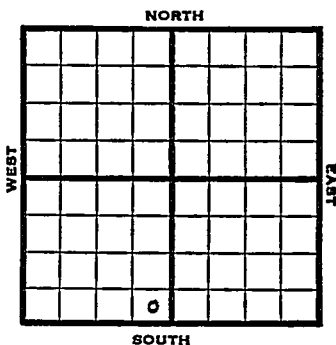

1953

Elev. 1096'

REPORT

1/28

Location

4/8

Spud 2-6-53

Oil Well

TD 3308

8" @ 90

TD 2315, lost surface casing

10" @ 60

Layton 2610, KC 2788, Peru 2927, Bart 3290,

TD 3308

5" @ 3292

CO to 3308, sd-oil-frac

S/25 bopd

Comp. 25 bopd

COMPLETED

