


Section 4 Township 34 Range 3E

Well No. #2 Collison "A" (Collinson)

Company McNish & Grallop

3

NORTH

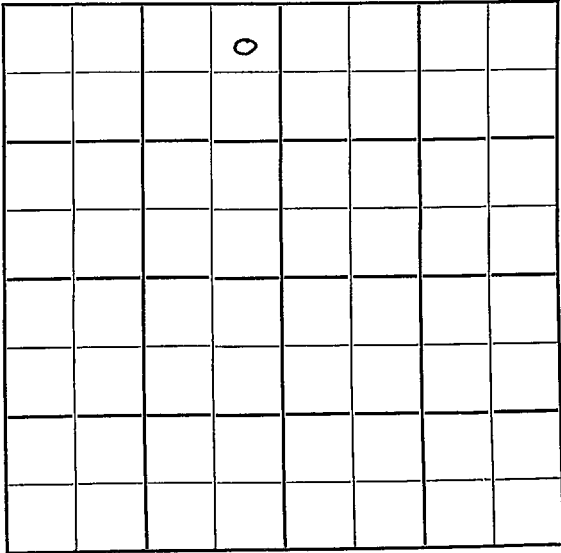

WEST

EAST

SOUTH

Cowley

KANSAS ✓

Sec. 4 Twp. 34 R. 3E

Well No. #2 Collison "A" Farm

McNish & Gallop Company

Watson Contractor


330 Ft. from N. Line

_____ Ft. from S. Line

330 Ft. from E. Line

_____ Ft. from W. Line

#1 Collison "A"

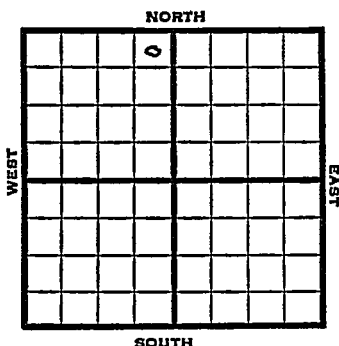

1952 Elev. 1102' REPORT

10/8 Spud 9-28-52
8" @ 110'
Drlg. 2105'

10/15 Spud Date: 9-28-52
D&A TD 3330'
8" @ 110
Miss 3328
TD 3330'
D&A

ABANDONED

County Cowley State Kansas

Sec. 4 (Blk. Twp.) 34 (Sur. Rge.) 3E Map No.

Operator McNish & Grallop

Well No. 2 Farm Collison "A"

Elev. Location NE NE NW

			0			
FIRST REPORT						

330 Ft. From N Line NW

330 Ft. From E Line Quarter.

1st. Report OCT 8 1952

Completion

Remarks

Watson - Contr.

Spudding Date 9-28-52

Drlg. Data

8" @ 110 drlg. 2105

J. G. McGEHEE

County Cowley State Kansas

Sec. 4 (Blk. Twp.) 34 (Sur. Rge.) 3E Map No.

Operator McNish & Grallop

Well No. 2 Farm Collison "A"

Elev. 1102 Location NE NE NW

			o		

330 Ft. From N Line NW

330 Ft. From E Line Quarter

1st. Report

Completion OCT 15 1952

Remarks

Watson - Contr.

Spudding Date 9-28-52

Drilg. Data D & A TD 3330

8" @ 110 Miss. 3328 TD 3330

D & A