

Map No. _____ Sec. 13 Twp. 29 R. 5


Well No. 1 Nader Farm _____

A 907

Company _____

Hartman & Davidson NORTH

WEST

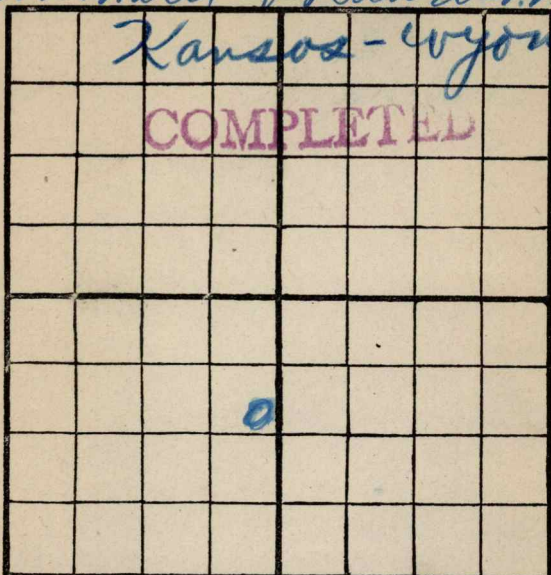

EAST

SOUTH

Location _____

Rig Up _____

Drilling Remarks:

Drilling Remarks:

RECORD

Cased _____ in. _____ ft.

Sand _____

Gas _____

Oil _____

Total Depth _____

PRODUCTION

1st 24 hrs. Nat. _____

1st 24 hrs. after shot _____

Gas _____ cu. ft

Dry Hole _____

Abandoned _____

Map No. _____ Sec. 12 Twp. 29 R. 3

Well No. 1 Naden Farm

Kao. Wyoming Company

N

11

W

四

S

Location -----

Drilling Remarks:

Rig Up -----

Drilling Remarks:

COMPLETED

RECORD

Cased ----- in.-----ft.

Sand -----

Gas -----

Oil _____

Total Depth_____

PRODUCTION

1st 24 hrs. Nat.-----

1st 24 hrs. after shot-----

Gas ----- cu. ft

Dry Hole -----

Abandoned -----

Map No. _____ Sec. 13 Twp. 29 R. 5Well No. ✓ Wade FarmKarron-Wyoming Company


Contractor

Sw Quarter990 Ft. from N. Line

Ft. from S. Line

330 Ft. from E. Line

Ft. from W. Line

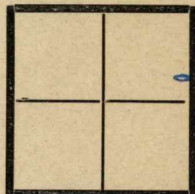~~DATA~~

REPORT

11/10 Dreg 1800'12/11 SD 1850'1/17/20 SD 1850'22 Dreg. 2395'29 SD 2395'2/2 fish Tools 2575'11 SP. 6" to 2575'24 Dreg 2700'3/3 SD 2775'23 Log 4R 27864/2 FFO 28334/10 Sand 2783-2836 - 50600.


COMPLETED

Map No. _____ Sec. 13 Twp. 29 R. 5
 Well No. 1 Kaden Farm _____
Kannan & Davidson Company

NORTH

WEST

EAST

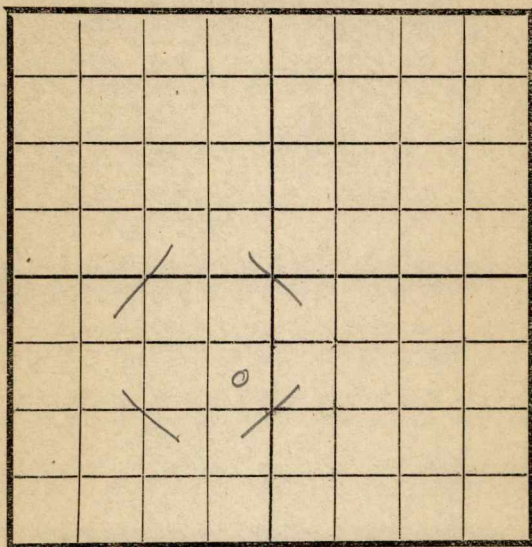

SOUTH

Location _____

Rig Up ☒ _____

Drilling and remarks

Ass / Oil
Co sub lease
This to above
parties

RECORD

Cased _____ in _____ Ft.

Sand _____

Gas _____

Oil _____

Total Depth _____

PRODUCTION

1st 24 hrs. Nat. _____

1st 24 hrs. after shot _____

Gas _____ Cu. Ft.

Dry Hole _____


Abandoned _____

Date

3/6, 1918 P. Condy Scout

Map No. _____ Sec. 13 Twp. 29 R. 5Well No. 1 _____Wannan & Duro CompanyBruce Hyde ContractorAugusta NORTH Ks

WEST

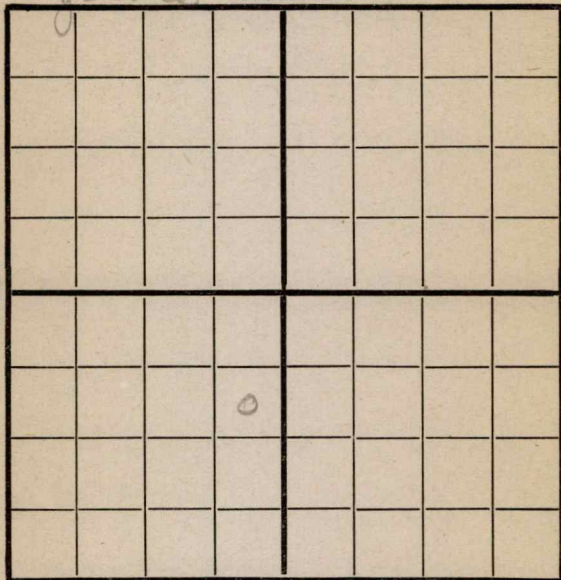

EAST

SOUTH

RECORD

Location _____

Cased _____ in., _____ ft.

Rig up _____

Sand _____

Drilling and Remarks:

Gas _____

Oil _____

Total Depth _____

PRODUCTION

1st 24 hrs. Nat. _____

1st 24 hrs. after shot _____

Gas _____ Cu. Ft.

Dry Hole _____

Abandoned _____

Date

7/3 191 8 C. C. C. C. Scout


Map No. _____ Sec. 13 Twp. 29 R. 5Well No. 1 ModernHammann & Davis Company

Contractor _____

NORTH

WEST

EAST

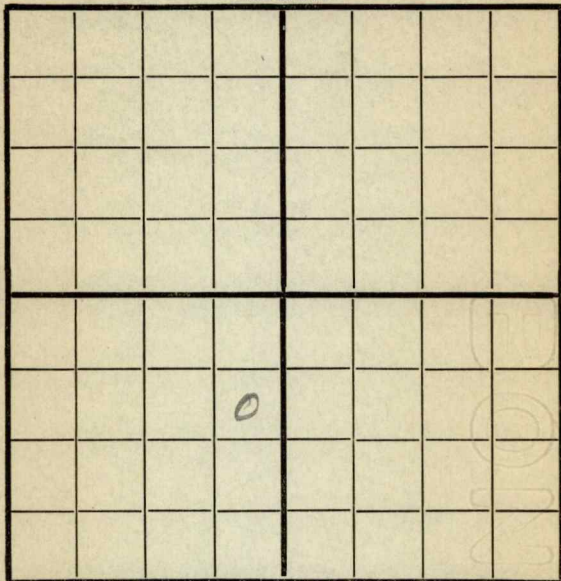

SOUTH

Location _____

Rig up _____

Drilling and Remarks:

1000

RECORD

Cased _____ in., _____ ft.

Sand _____

Gas _____

Oil _____

Total Depth _____

PRODUCTION

1st 24 hrs. Nat. _____

1st 24 hrs. after shot _____

Gas _____ Cu. Ft.

Dry Hole _____

Abandoned _____

Date

7/10 S. C. Cady 191 _____ Scout

Map No. _____ Sec. 13 Twp. 27 R. 3

Well No. 1. Hobbs

Wanamaker & Davis Company

Contractor

NORTH

WEST

EAST

SOUTH

Location _____

Rig up.....

Drilling and Remarks:

RECORD

Cased _____ in., _____ ft.

Sand.....

Gas

Oil _____

Total Depth.....

PRODUCTION

1st 24 hrs. Nat.

1st 24 hrs. after shot-----

Gas.....Cu. Ft.

Dry Hole

Abandoned.....

Date _____

7/17 J. C. ... 191 Scout


Map No. _____ Sec. 13 Twp. 29 R. 5Well No. 1 AndersonAnderson & Sons Company

Contractor _____

NORTH

WEST

EAST

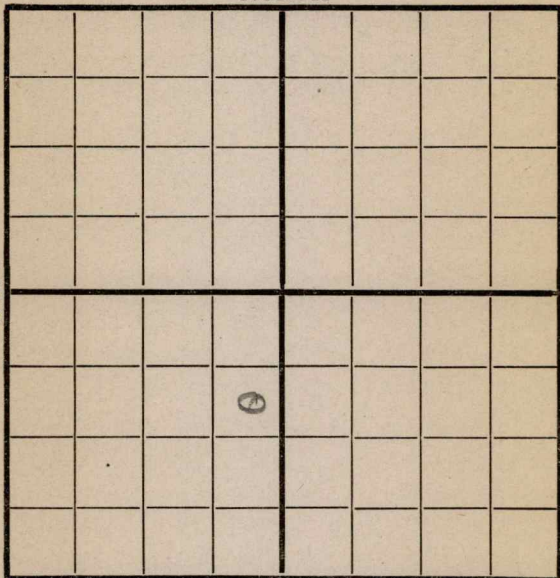

SOUTH

Location _____

Rig up _____

Drilling and Remarks:

1500

RECORD

Cased _____ in., _____ ft.

Sand _____

Gas _____

Oil _____

Total Depth _____

PRODUCTION

1st 24 hrs. Nat. _____

1st 24 hrs. after shot _____

Gas _____ Cu. Ft.

Dry Hole _____

Abandoned _____

Date


7/24 191 J. C. Anderson Scout

Map No. _____ Sec. 13 Twp. 29 R. 5Well No. 1 KabeuParsons & Dandson Company_____
Contractor

NORTH

WEST

EAST

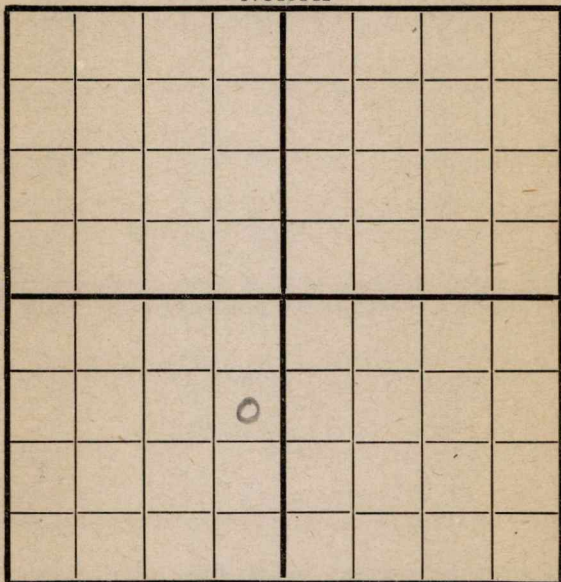

SOUTH

330 W 7 E x 990 S 7 E L

Location _____

Rig up _____

Drilling and Remarks:

Fishing 1800

RECORD

Cased _____ in., _____ ft.

Sand _____

Gas _____

Oil _____

Total Depth _____

PRODUCTION

1st 24 hrs. Nat. _____

1st 24 hrs. after shot _____

Gas _____ Cu. Ft.

Dry Hole _____

Abandoned _____

Date

7/31 191 S. Candiff Scout

Map No. _____ Sec. 13 Twp. 29 R. 5
Well No. 1 Kaden
Kanawha & Dindan Company

Contractor _____

NORTH							
WEST							
SOUTH							

330 E
Location 99.77

Rig up _____
Drilling and Remarks:
2000

RECORD	
Cased	_____ in., _____ ft.
Sand	_____
Gas	_____
Oil	_____
Total Depth	_____
PRODUCTION	
1st 24 hrs. Nat.	_____
1st 24 hrs. after shot	_____
Gas	_____ Cu. Ft.
Dry Hole	_____
Abandoned	_____

Date 8/7 J. B. Bandy Scout
_____ 191 _____

A blank 8x8 grid with a thick central cross. The word "NORTH" is at the top, "WEST" on the left, and "EAST" on the right. A small blue circular mark is in the bottom-left quadrant.

990th N - 320' S SOUTH

Drilling and Remarks:

2145

Total Depth_____

Abandoned.....

8/21 1918. Conley Scout


Map No. _____ Sec. 13 Twp. 29 R. 5Well No. 1424Ransom & Davidson Company

Contractor _____

NORTH

WEST

EAST

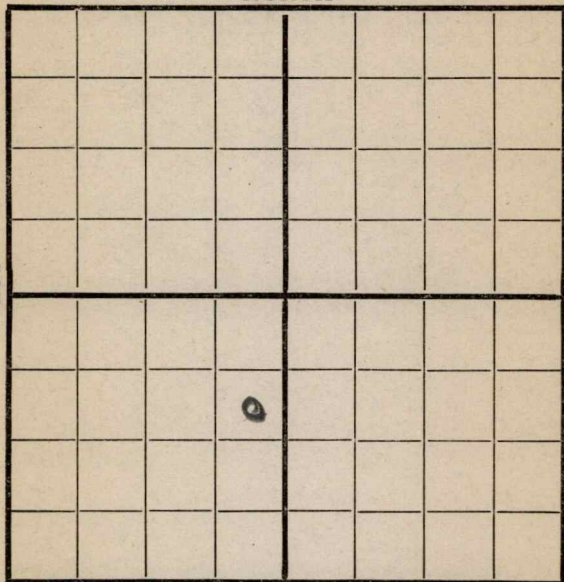

SOUTH

990 N 330 E

Location _____

Rig up _____

Drilling and Remarks:

RECORD

Cased _____ in., _____ ft.

Sand _____

Gas _____

Oil _____

Total Depth _____

PRODUCTION

1st 24 hrs. Nat. _____

1st 24 hrs. after shot _____

Gas _____ Cu. Ft.

Dry Hole _____

Abandoned _____

Date

8/28/8 Candiff Scout

191

2390


Map No. _____ Sec. 13 Twp. 29 R. 5Well No. 144Ramsey & Dorman Company

Contractor _____

NORTH

WEST

EAST

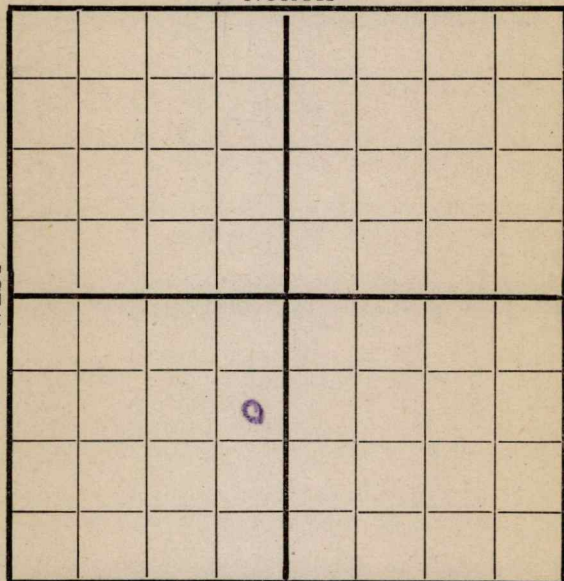

SOUTH

Location _____

Rig up _____

Drilling and Remarks:

2500

RECORD

Cased _____ in., _____ ft.

Sand _____

Gas _____

Oil _____

Total Depth _____

PRODUCTION

1st 24 hrs. Nat. _____

1st 24 hrs. after shot _____

Gas _____ Cu. Ft.

Dry Hole _____

Abandoned _____

Date

9/4 191 S. C. Cardiff Scout

Map No. 11 Sec. 13 Twp. 29 R. 5

Well No. 1 Kaden


Vanaman & Dindane Company

Contractor

NORTH

WEST

EAST

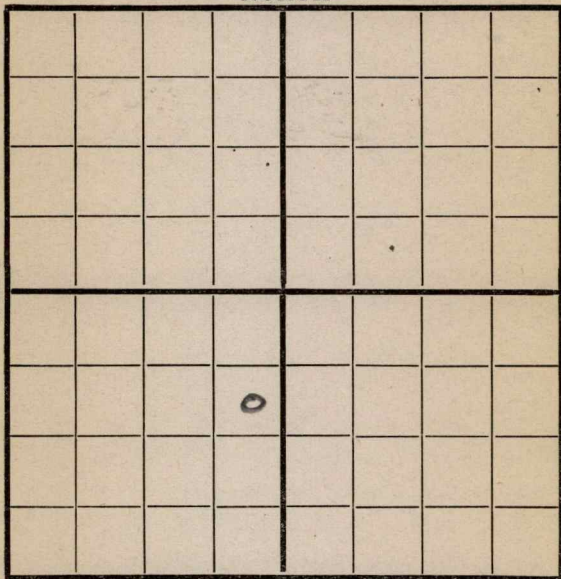

SOUTH

990 X 530 E

Location

Rig up

Drilling and Remarks:

222750
Store 3 strings
tool in hole

RECORD

Cased _____ in., _____ ft.

Sand _____

Gas _____

Oil _____

Total Depth _____

PRODUCTION

1st 24 hrs. Nat. _____

1st 24 hrs. after shot _____

Gas _____ Cu. Ft.

Dry Hole _____

Abandoned _____

Date

10/16 1918

Quincy

Scout


Map No. 154 Sec. 13 Twp. 29 R. 5
 Well No. 1202
Wainwright & Davidson Company

Contractor

NORTH

WEST

EAST

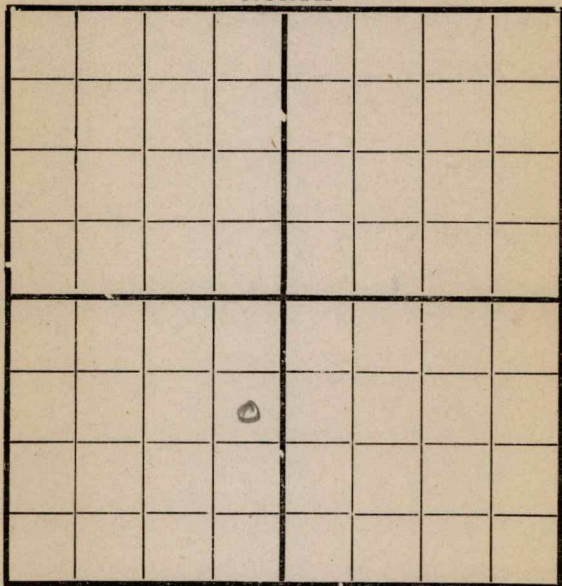

SOUTH

990 N 330 E

Location

Rig up

Drilling and Remarks:

Fishing
2730

RECORD

Cased _____ in., _____ ft.

Sand _____

Gas _____

Oil _____

Total Depth _____

PRODUCTION

1st 24 hrs. Nat. _____

1st 24 hrs. after shot _____

Gas _____ Cu. Ft.

Dry Hole _____

Abandoned _____

Date

12/4 191 8 Condy Scout

Map No. K11 Sec. 13 Twp. 29 R. 5Well No. 1 Naden
Vaniman & Davison Company

Contractor

NORTH

WEST

EAST

			0				

SOUTH

990 N

330 E

Location

Rig up

Drilling and Remarks:

fishing for
4 String tools
@
2730

RECORD

Cased _____ in., _____ ft.

Sand _____

Gas _____

Oil _____

Total Depth _____

PRODUCTION

1st 24 hrs. Nat. _____

1st 24 hrs. after shot _____

Gas _____ Cu. Ft.

Dry Hole _____

Abandoned _____

Date

3/8

191 9

Pyle

Scout


Map No. K11 Sec. 13 Twp. 29 R. 5Well No. 1 Naden
Kansas Wyoming Oil Company

Contractor

NORTH

WEST

EAST

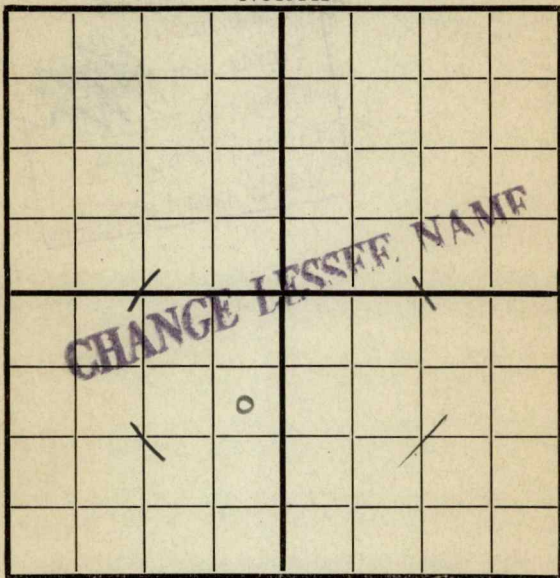

330 E

SOUTH

990 N

Location _____

Rig up _____

Drilling and Remarks:

Skid rig60' east

RECORD

Cased _____ in., _____ ft.

Sand _____

Gas _____

Oil _____

Total Depth _____

PRODUCTION

1st 24 hrs. Nat. _____

1st 24 hrs. after shot _____

Gas _____ Cu. Ft.

Dry Hole _____

Abandoned _____

Date

7/18

191

9Pyle

Scout

Map No. K 11 Sec. 13 Twp. 29 R. 5
 Well No. 1 Madison
Kansas Hyomring Company
 Contractor

NORTH							
WEST							
							EAST
SOUTH							

330 E 990 N

Location _____

Rig up _____

Drilling and Remarks:

Rig up

RECORD

Cased _____ in., _____ ft.

Sand _____

Gas _____

Oil _____

Total Depth _____

PRODUCTION

1st 24 hrs. Nat. _____

1st 24 hrs. after shot _____

Gas _____ Cu. Ft.

Dry Hole _____

Abandoned _____

Date

7/21 1919 Byh Scout

Map No. K 11 Sec. 13 Twp. 29 R. 5
Well No. 1 Naden
Kansas-Hyoming Company
Contractor

SECTION PLAT

990 Ft. from N. Line
Ft. from S. Line
330 Ft. from E. Line
Ft. from W. Line

FIRST REPORT

Location _____
Rig up _____
Drilling and Remarks:

Rig' n up

RECORD

Cased _____ in., _____ ft.
Sand _____
Gas _____
Oil _____
Total Depth _____

PRODUCTION

1st 24 hrs. Nat. _____
1st 24 hrs. after shot _____
Gas _____ Cu. Ft.
Dry Hole _____
Abandoned _____

Date 7/21 1919 Pyle Scout

Map No. 11 Sec. 13 Twp. 29 R. 5Well No. 2 Naden9-1-Oil & Gas Company

Contractor

SECTION PLAT

Ft. from N. Line

1070 Ft. from S. Line250 Ft. from E. Line

Ft. from W. Line

Location

Rig up

Drilling and Remarks:

Shot 40 gts

RECORD

Cased _____ in., _____ ft.

Sand 2866 - 2843

Gas _____

Oil _____

Total Depth _____

PRODUCTION

1st 24 hrs. Nat. _____

1st 24 hrs. after shot 100 bbl

Gas _____ Cu. Ft.

Dry Hole _____

Abandoned _____


Date

9/28 191 9

Pyle

Scout

Map No. K 11 Sec. 13 Twp. 29 R. 5
 Well No. 1 Naden Farm
Kansas - Wyoming Company
 Date Started _____ Ft. from N 990 S. E 330 W. line
NORTH

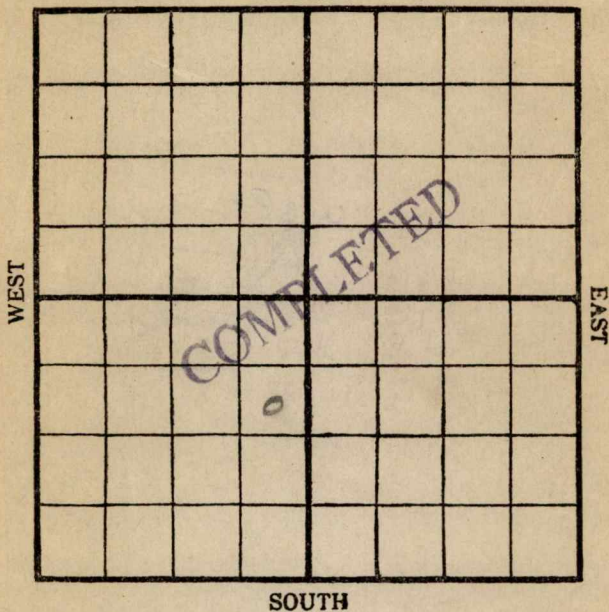

Cased _____ In. _____ Ft. _____

Sand 2783-2836

Pay { Gas _____
 Oil _____

Total Depth _____

Production Remarks

1st 24 hrs. 50 bbls

Condition of Well on this date _____

all gas well }

Pyle

Scout