


Section.....5.....Township..34.....Range 3-E

Well Number.....2 - Collison (Collinson)

Company.....Sinclair-Prairie

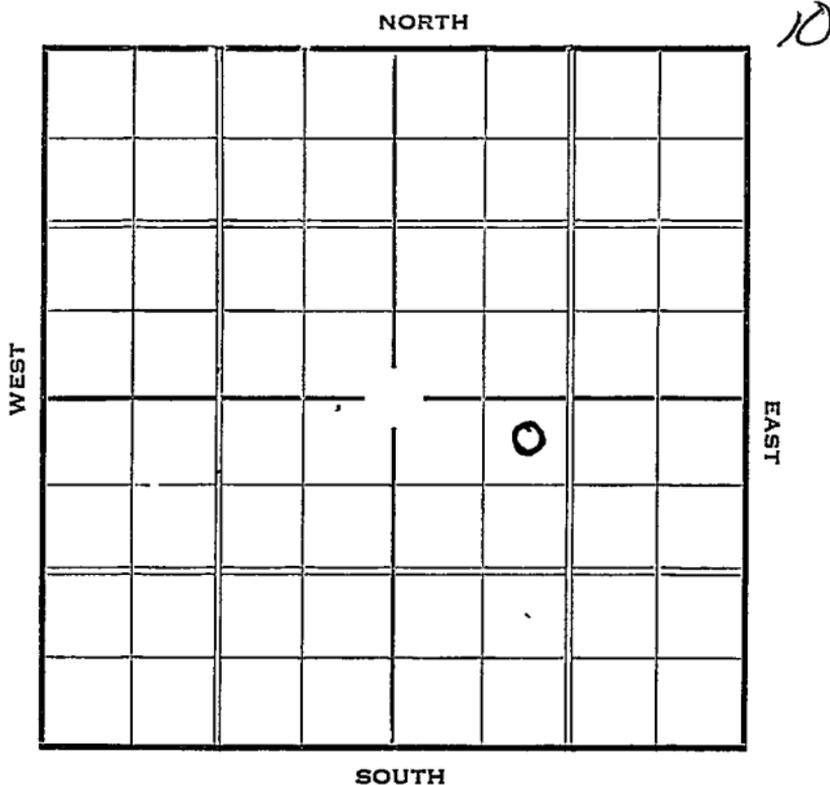

Sec. 5 Twp. 34 R. 3-E

Well No. #2 Collinson Farm


Sinclair-Prairie Company

330 Ft. from N. Line

\_\_\_\_\_ Ft. from S. Line

\_\_\_\_\_ Ft. from E. Line

990 Ft. from W. Line

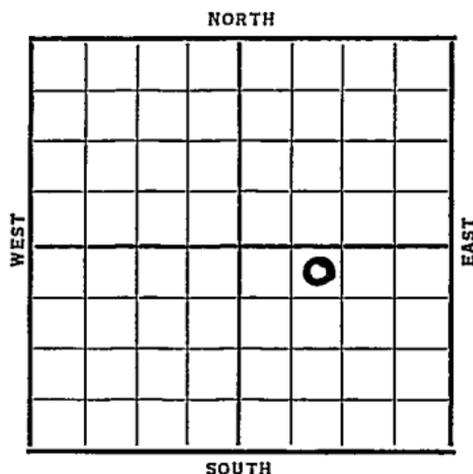

Elev. 1098

Date	REPORT
1937	
5/19	Location
5/28	Rig
6/4	"
6/11	12" @ 134'. Drlg. 1720'.
6/19	Drlg. 2978'.
6/25	7" @ 3270'. RUST.
7/2	Bart. 3290'. Chat 3321'.
	100000 gas @ 3291'.
	S.O. 3308-15'. T.D. 3325'.
7/9	" " " "
7/16	Flowed 47 bbls. 4 hrs.
7/23	" " " "
7/30	" " " "
8/4	7" @ 3270'
	Bart 3290'
	Chat 3321'
	TD 3325'
	Shot 30-qts.
	Pot 54 bbls.
	Flowing

COMPLETED

Cowley **KANSAS**Map No. 1 Sec. 5 Twp. 34 R. 3EWell No. 2 - CollinsonSinclair Prairie Company

Contractor

**FIRST REPORT**330 Ft. from N. Line

\_\_\_\_\_ Ft. from S. Line

\_\_\_\_\_ Ft. from E. Line

990 Ft. from W. Line**SECTION PLAT**

		0	

Location ✓

Rig up \_\_\_\_\_

Drilling and Remarks:

**RECORD**

Cased \_\_\_\_\_ in., \_\_\_\_\_ ft.

Sand \_\_\_\_\_

Gas \_\_\_\_\_

Oil \_\_\_\_\_

Total Depth \_\_\_\_\_

**PRODUCTION**

1st 24 hrs. Nat. \_\_\_\_\_

1st 24 hrs. after shot \_\_\_\_\_

Gas \_\_\_\_\_ Cu. Ft.

Dry Hole \_\_\_\_\_

Abandoned \_\_\_\_\_

Date

MAY 19 ~~1937~~ 19

H. D. Hatfield

Scout

Cowley KANSASMap No. 1 Sec. 5 Twp. 34 R. 3 EWell No. 2 - CollinsonSinclair Prairie Company

Contractor

COMPLETED

330 Ft. from N. Line

\_\_\_\_\_ Ft. from S. Line

\_\_\_\_\_ Ft. from E. Line

990 Ft. from W. Line

## SECTION PLAT

		0	

Location \_\_\_\_\_

Rig up \_\_\_\_\_

Drilling and Remarks:

Shot 30 gtsPat 54 bblsflowing

## RECORD

Cased 7 in., 3270ft.Sand Bart 3290Gas Chat 3321

Oil \_\_\_\_\_

Total Depth 3325

## PRODUCTION

1st 24 hrs. Nat. \_\_\_\_\_

1st 24 hrs. after shot \_\_\_\_\_

Gas \_\_\_\_\_ Cu. Ft.

Dry Hole \_\_\_\_\_

Abandoned \_\_\_\_\_

Date

Aug 4 - 1937

19

E. D. Hatfield Scout