


Section 24 Township 16 Range 11<sup>W</sup>

Well No. #6 Siemsen

Company Derby Oil etal

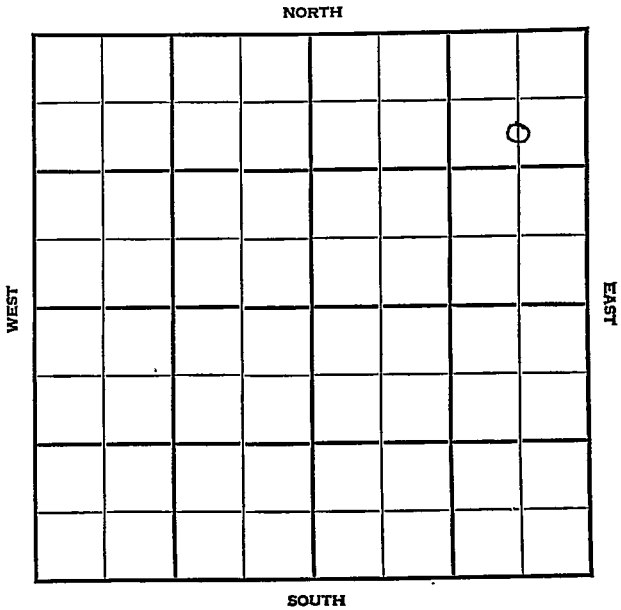



Sec. 24 Twp. 16 R. 14W

Well No. #6 Siemsen Farm

Derby Oil et al Company

Trapp Pool


990' Ft. from N. Line

\_\_\_\_\_ Ft. from S. Line

660' Ft. from E. Line

\_\_\_\_\_ Ft. from W. Line

C S L NE NE

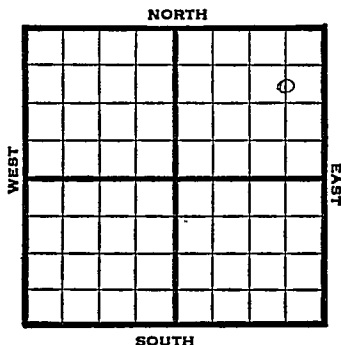

1948 Eli 1912' REPORT

6/23 8" @ 631'  
Drlg. 1715'

6/29 Drlg. 3295'

7/8 Lansing 3120'  
Arbuckle 3354'  
TD 33722  
4 1/2" @ 3371'

7/14 TD 3381  
500 acid  
Swb 12 bbls oil / 23 W PH  
" " "

7/21 " " "

7/28 67 shots 3354-69- 500 acid  
Swb 3 bbls oil / 150 W in 24 hrs.

8/4 " " "

8/11 " " "

8/18 " " "

8/25 Arb. 3354'  
4" @ 3371'  
TD 3381'  
5000 acid  
Pump 30 oil / 150 W Pot  
41° Gr.  
Comp

**COMPLETED**

Map No. \_\_\_\_\_ Sec. 24 Twp. 16 R. 14W

Well No. 6 Siemsen

\_\_\_\_\_ Derby Oil etal. \_\_\_\_\_ Company

**FIRST REPORT**

\_\_\_\_\_ Contractor

C S L NE NE

**SECTION PLAT**

990 Ft. from N. Line

\_\_\_\_\_ Ft. from S. Line

660 Ft. from E. Line

\_\_\_\_\_ Ft. from W. Line

|  |  |  |  |
|--|--|--|--|
|  |  |  |  |
|  |  |  |  |
|  |  |  |  |
|  |  |  |  |

Barton County

**RECORD**

Location \_\_\_\_\_

Cased \_\_\_\_\_ in., \_\_\_\_\_ ft.

Rig up \_\_\_\_\_

Sand \_\_\_\_\_

Drilling and Remarks:

Gas \_\_\_\_\_

8" @ 631

Oil \_\_\_\_\_

drlg. 1715

Total Depth \_\_\_\_\_

**PRODUCTION**

1st 24 hrs. Nat. \_\_\_\_\_

1st 24 hrs. after shot \_\_\_\_\_

Gas \_\_\_\_\_ Cu. Ft.

Dry Hole \_\_\_\_\_

Abandoned \_\_\_\_\_

Date

JUN 23 1948 19 S. J. LEWIS Scout

Barton County Kansas State

Map No. 73 Sec. 24 Twp. 16 R. 14WWell No. 6 Siemsen

Derby Oil etal. Company

COMPLETE

Contractor

C S L NE NE

E. 1912  
SECTION PLAT990 Ft. from N. Line

Ft. from S. Line

660 Ft. from E. Line

Ft. from W. Line

|  |  |  |  |  |  |  |  |
|--|--|--|--|--|--|--|--|
|  |  |  |  |  |  |  |  |
|  |  |  |  |  |  |  |  |
Trapp Pool

Remarks:

*Art 3354**4" @ 3371**YTD 3381**5000 acid**Puny soil + 150W R-2**4/2/48*Date  
AUG 25 1948Scout  
S. J. LEWIS