


Section 29 Township 16 Range 14 WWell No. # 1 SchneiderCompany Derby Drlg.

NORTH

WEST

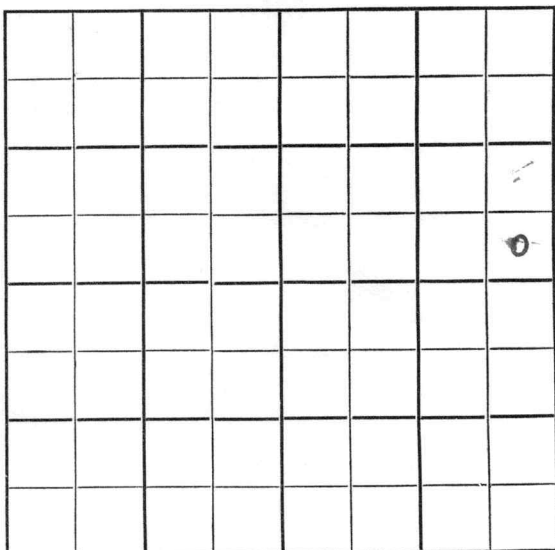

EAST

SOUTH

Sec. 29 Twp. 16 R. 14W

Well No. #1 Schneider Farm

Derby Drlg. Company

Rocket Contractor


Wildcat

_____ Ft. from N. Line

330 Ft. from S. Line

330 Ft. from E. Line

_____ Ft. from W. Line

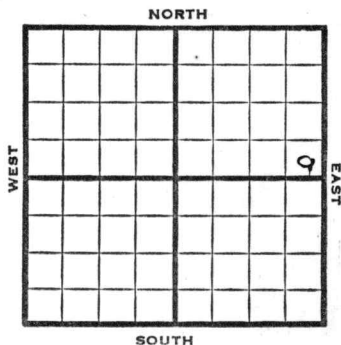

SE SE NE

Amerada \$2500

Musgrove-acreage

1952

Elev. 2000'

REPORT

8/13

Spud 8-11-52
8" @ 284'

8/20

Anhy 987' Howard 2860'
Topeka 2930' Heeb 3164'
Douglas 3197' KC 3233'
DST 3240-77, 1 hr, 10' M 500#
Drlg. 3310'

8/27

DST 3290-3324 3/4 hr. 10' M 1100#
Sho Cong 3459 Cherty Cong 3466
Arb. 3477
DST 3449-79 3/4 hr. 20' M
DST 3479-85 1 hr. 10' M 1150#
DST 3483-93 1 hr. 30' M & trace
oil 190#
DST 3488-97 2-hr. 60' gas 10' OCM
120' HvyOCM 610# RTD 3517
5" @ 3517

9/4

Spud 8-11-52
D&A TD 3517' 8" @ 284'
Anhy 987 Howard 2860
Top. 2930 Heeb. 3164
Doug. 3197 KC 3233
DST 3240-77 open 1 hr. rec. 10' mud
500 #
DST 3290-3324 open 3/4 hr. rec. 10' mud
1100# Cong. 3459
~~Ch~~ Ch Cong. 3466 Arb. 3477

OVER

1952

9/4 DST 3449-79 open 3/4 hr. rec. 20' mud
0#
DST 3479-85 open 1 hr. rec. 90' mud
1150#
DST 3483-93 open 1 hr. rec. 30' mud
190#
DST 3488-97 open 2 hr. rec. 60' gas
10' ocm 120' hocm 610#
TD 3517 5" @ 3517' 60 to 3504
6/ 3490-92 S/ 1½ bwph PB 3485
12/ 3476-80 3/ 3480-81 9/ 3480-83
12/ 3481-85 500 A S/ 10 gph D&A


ABANDONED

County **Barton** State **Kansas**
 Sec. **29** (Blk.) **16** (Sur.) **14W** Map No.

Operator **Derby Drlg.**

Well No. **1** Farm **Schneider**

Elev. Location **SE SE NE**

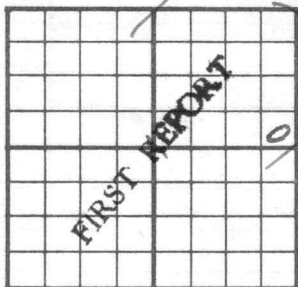

330 Ft. From **S** Line **NE**

330 Ft. From **E** Line Quarter

1st. Report **AUG 13 1952**

Completion

Amerada \$2500.

Remarks


Musgrove - acreage
Rocket - Contr.

Spudding Date **8-11-52**

Drlg. Data **Wilcat**

8" @ 284

J. G. McGEHEE

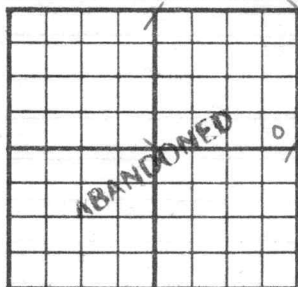County Barton State KansasSec. 29 (Blk. 16) (Sur. 14W) (Twp. 16) Map No. 14WOperator Derby Drlg.Well No. 1 Farm SchneiderElev. 2000 Location SE SE NE330 Ft. From S Line NE330 Ft. From E Line Quarter1st. Report Completion SEP 4 1952Remarks WildcatRockett Drlg. - Contr.Spudding Date 8-11-52Drlg. Data D & A TD 35178" @ 284 Anhy 987 Howard 2860Top. 2930 Heeb. 3164 Doug. 3197KC 3233 DST 3240-77 open 1 hr. Rec.10' mud 500# DST 3290-3324 open 3/4 hrRec. 10' mud 1100# Cong. 3459Ch. Cong. 3466 Arb. 3477 DST 3449-79open 3/4 hr. Rec. 20' mud 0# DST 3479-85 open 1 hr. Rec. 90' mud 1150#DST 3483-93 open 1 hr. Rec. 30' mud190# DST 3488-97 open 2 hr. Rec.60' gas 10' ocm 120' hocm 610#TD 3517 5" @ 3517 CO to 35046/ 3490-92 S/ 1 1/2 bwph PB 348512/ 3476-80 3/ 3480-81 9/ 3480-83

J. G. McGEHEE

Drlg. Data

12/ 3481-85

500 A S/ 10 gph

SEP 10 1952

Misc
Pierce Map
France Map
Tracings
Land Wall Map
Land Small Map
Scout Cards

[Handwritten signature]