


Barton

Section 30 Township 16 Range 14W

Well No. #1 Athin

Company Phillips

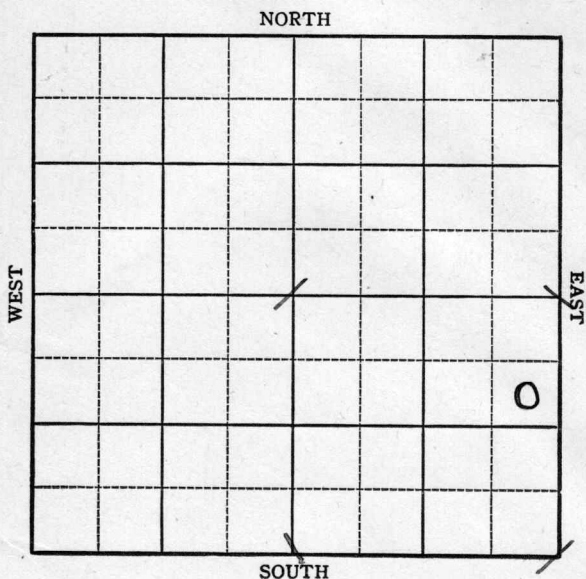

KANSAS


Barton

Sec. 30 Twp. 16 R. 14-W

Well No. #1 Athin Farm

Phillips Company

NORTH

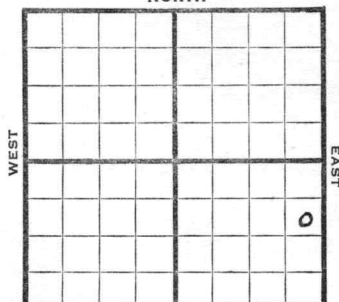

990 Ft. from N. Line

 Ft. from S. Line

330 Ft. from E. Line

 Ft. from W. Line

Wildcat

1944

REPORT

3/15 8" @ 655'
WOC.

3/22 Drlg. 2680'

3/29 Lans 3110
Cong 3426
Arb 3458
TD 3488
No shows.


ABANDONED

KANSAS
Map No. 73 Sec. 30 Twp. 16 R. 14WWell No. 1 AthinPhillips Company

FIRST REPORT Contractor

SE NE SE

SECTION PLAT

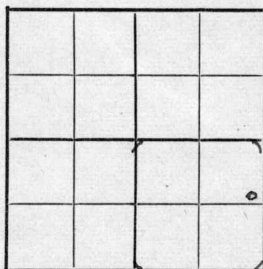990 Ft. from N. Line Ft. from S. Line330 Ft. from E. Line Ft. from W. Line

Wildcat

Location Rig up

Drilling and Remarks:

8" - 655 WOC

RECORD

Cased in., ft.Sand Gas Oil Total Depth

PRODUCTION

1st 24 hrs. Nat. 1st 24 hrs. after shot Gas Cu. Ft.Dry Hole Abandoned

Date

MAR 15 1944 19

S. J. LEWIS Scout

Barton

KANSAS

Map No. 73 Sec. 30 Twp. 16 R. 14WWell No. 1 AtkinPhillips

Company

ABANDONED

Contractor

SE NE SE

SECTION PLAT

990


Ft. from N. Line

Ft. from S. Line

330

Ft. from E. Line

Ft. from W. Line

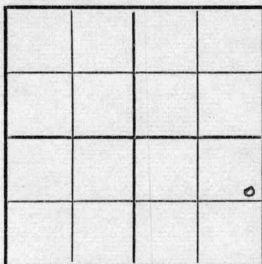

Wildcat

Location

Rig up

Drilling and Remarks:


RECORD

Cased _____ in., _____ ft.

Sand _____

Gas _____

Oil _____

Total Depth 3488

PRODUCTION

1st 24 hrs. Nat. _____

1st 24 hrs. after shot 1

Gas _____ Cu. Ft.

Dry Hole _____

Abandoned _____

Date

MAR 29 1944 19

S. J. LEWIS Scout