


KANSAS Barton

Section 25 Township 16 Range 14W

Well No. 1 Peach

Company Alpine Oil & Royalty

Trapp Pool

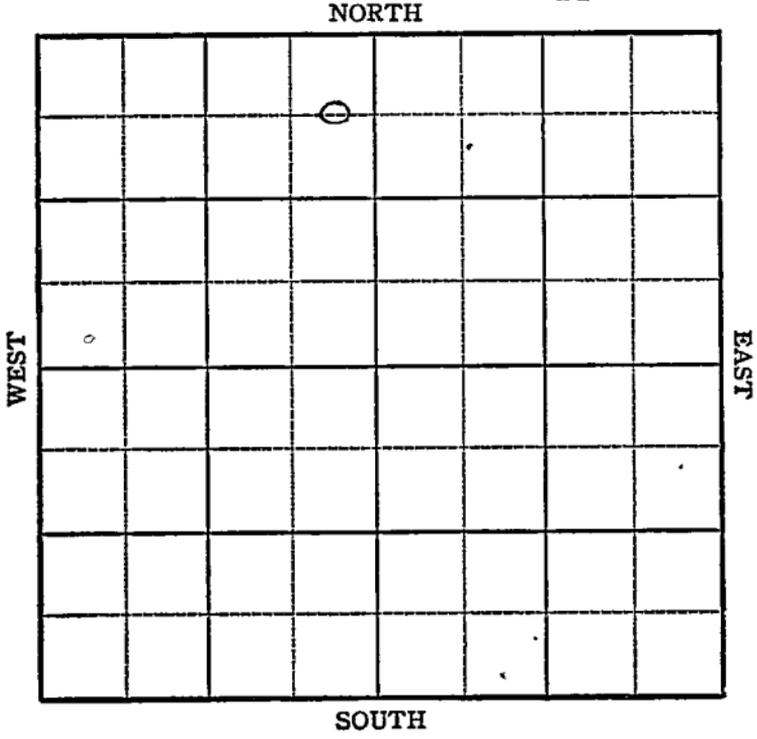

KANSAS

Barton



Sec. 25 Twp. 16 R. 14W

Well No. #1 Peach Farm

Alphine Oil & Royalty Company

Trapp Pool


660' Ft. from N. Line

Ft. from S. Line

630' Ft. from E. Line

Ft. from W. Line

C E L NE NW

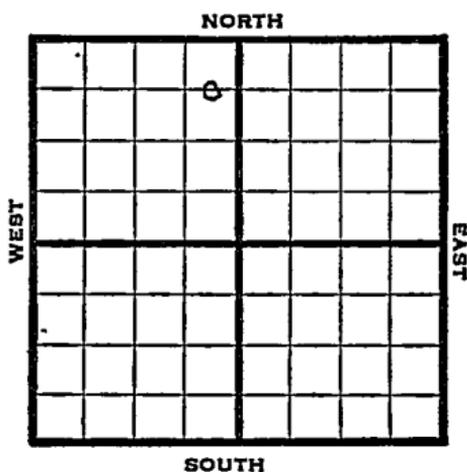

1948

Eli 1967'

REPORT

8/18

8" @ 228'

Anhy. 954'

Drlg. 2113'

8/25

Lansing 3188'

Arb. 3414'

TD 3476'

Aband.

ABANDONED

Barton County Kansas State

Map No. _____ Sec. 25 Twp. 16 R. 14W

Well No. 1 Peach

Alpine Oil & Royalty Company

FIRST REPORT

Contractor

C E L NE NW

SECTION PLAT

660 Ft. from N. Line

_____ Ft. from S. Line

330 Ft. from E. Line

_____ Ft. from W. Line

Trapp Pool

Remarks:

8" @ 228

anhy 954" drlg. 2113

Date

Scout S. J. LEWIS

AUG 1 8 1948

Barton County Kansas State

Map No. 73 Sec. 25 Twp. 16 R. 14W

Well No. 1 Peach

Alpine Oil & Royalty Company

ABANDONED

Contractor

C E L NE NW

E, 1967
SECTION PLAT

660 Ft. from N. Line

 Ft. from S. Line

330 Ft. from E. Line

 Ft. from W. Line

Trapp Pool

Remarks:

lane 3188

cut 3414

Y 3476

Date
AUG 25 1948

Scout
S. J. LEWIS