


Section 27 Township 16 Range 11W

Well No. #1 Eveleigh

Company BeardmoreDrlg.

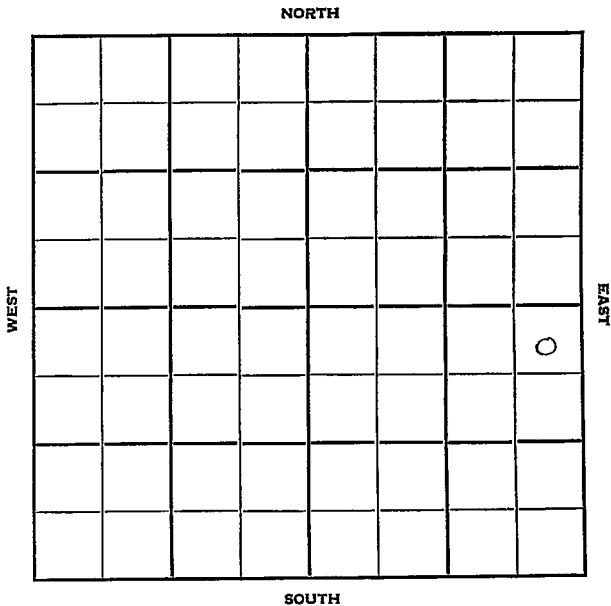

Barton

KANSAS

Sec. 27 Twp. 16 R. 14W ✓

Well No. #1 Eveleigh Farm

Beardmore Drlg. Company

Wildcat Contractor


330' Ft. from N. Line

Ft. from S. Line

330' Ft. from E. Line

Ft. from W. Line

NE NE SE

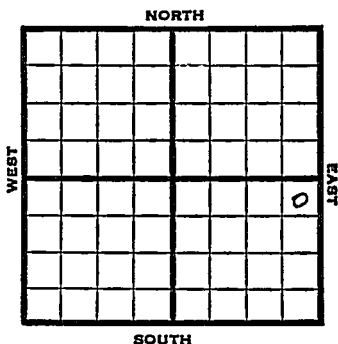

1951

Elev. 1935' REPORT

8/29

Location

9/19

Spud 9-6-51


D & A TD 3512' 8" @ 285

Lans. 3168' Cong. 3396' Arb. 3478

TD 3512' D & A

ABANDONED

County Barton State Kansas
 Sec. 27 (Blk. 16 (Sur. 14W Map No.
 (Twp.) (Rge.)
 Operator Beardmore Drig.
 Well No. 1 Farm Eveleigh
 Elev. Location NE NE SE

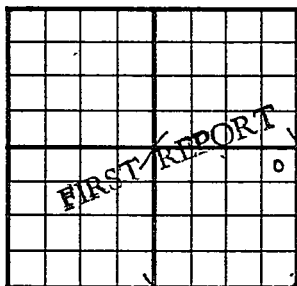

330 Ft. From N Line SE
330 Ft. From E Line Quarter
 Ist. Report AUG 20 1951
 Completion
 Remarks Texas & Sinc. DHM


Spudding Date

Drlg. Data

Wildcat

Location

J. E. TYRA

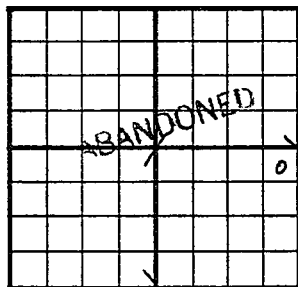County Barton State KansasSec. 27 (Blk.
Twp.) 16 (Sur.
Rge.) 14W Map No.Operator Beardmore Drlg.Well No. 1 Farm EveleighElev. 1935 Location NE NE SE330 Ft. From N Line SE330 Ft. From E Line QuarterIst. ReportCompletion SFP 1 9 1951Remarks WildcatSpudding Date 9-6-51Drlg. Data D & A TD 35128" @ 285 Lans. 3168 Cong. 3396Arb. 3478 TD 3512D & A

J. E. TYRA