


Section 29 Township 16 Range 11W

Well No. #1 Poopp (POPP)

Company Musgrove Pet.

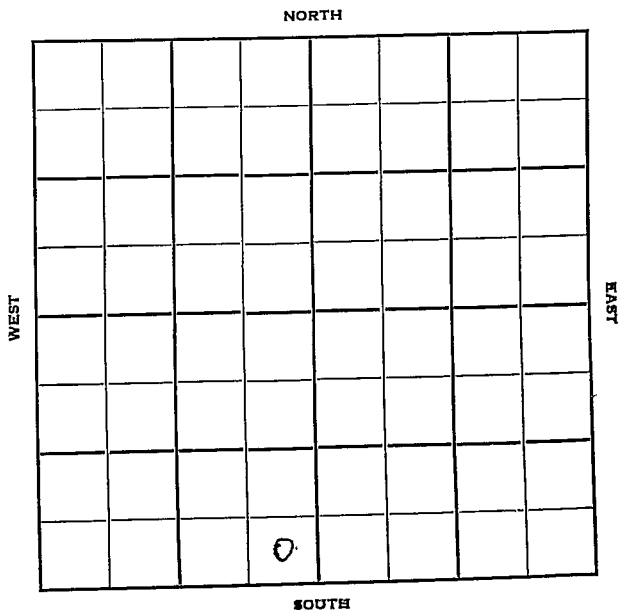

KANSAS
16

Barton
14-W

Sec. 29 Twp. _____ R. _____

Well No. #1 Popp Farm _____

Musgrove Pet. Company _____

Contractor _____

Wildcat


_____ Ft. from N. Line

330 Ft. from S. Line

330 Ft. from E. Line

_____ Ft. from W. Line

SE SE SW

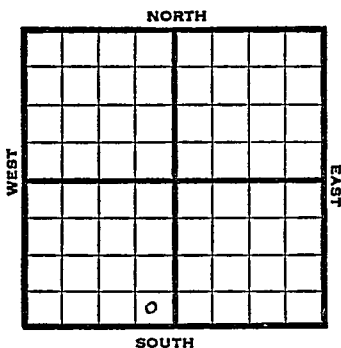

1950 Elev 1996 REPORT

7/26 Rig Up

8/16 8" @ 657

Anhy 984

Heeb 3153

Lans 3216

DST 3222-52 opn 1 hr rec 200' oil & gcm

300' g & wc oil

370' ocw 60' wtr

Arb 3480

TD 3490

D&A

ABANDONED

Map No. _____ Sec. 29 Twp. 16 R. 14W

Well No. 1 Popp

Musgrove Pet. _____ Company

Contractor

SE SE SW

SECTION PLAT

_____ Ft. from N. Line

330 Ft. from S. Line

330 Ft. from E. Line

_____ Ft. from W. Line



Barton County

Location _____

Rig up

Drilling and Remarks:

RECORD

Cased _____ in., _____ ft.

Sand _____

Gas _____

Oil _____

Total Depth _____

PRODUCTION

1st 24 hrs. Nat. _____

1st 24 hrs. after shot _____

Gas _____ Cu. Ft.

Dry Hole _____

Abandoned _____

Date

JUL 26 1950 19

J. E. TYRA Scout

