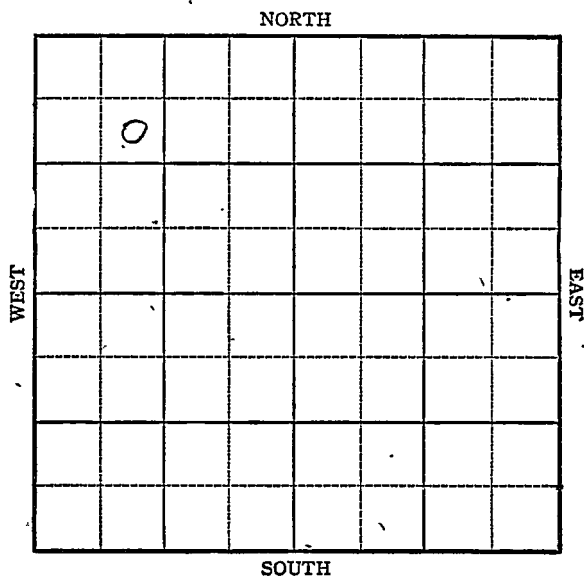


KANSAS

Barton County

Section 35 Township 16 Range 14WWell No. #1 LoganCompany McGuire Inc.

KANSAS

Barton County

Sec. 35 Twp. 16 R. 14W

Well No. #1 Logan Farm

McGuire Inc. Company

Wildcat

990 Ft. from N. Line


Ft. from S. Line

Ft. from E. Line

990 Ft. from W. Line

SE NW NW

Elev. 1913

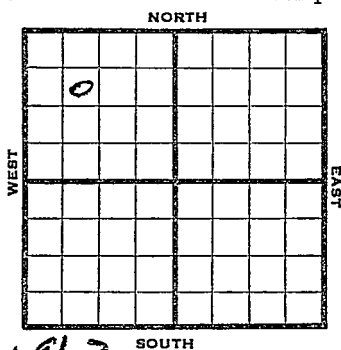

1944

R E P O R T

10/18 Location

10/25 RUR

11/2 8" @ 305

Anhy 905

Drlg. 1920

11/8 Drlg. 2915

11/16 Lan's 3185

Cong 3409

Drlg. 3456 in cong.

11/24 T D 3474 S D

11/29 " " "

12/6 Cong. 3709

TD 3474' in Cong

ABANDONED

Pool Name Wildcat

KANSAS

Map No. 73 Sec 35 Twp. 16 R. 14WWell No. 1 LoganMcGuire Inc.


Company

FIRST REPORT

Contractor

SE NW NW

SECTION PLAT

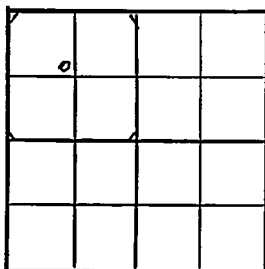990 Ft. from N. Line Ft. from S. Line Ft. from E. Line990 Ft. from W. LineBartonLocation XRig up Drilling and Remarks:

RECORD

Cased in., ft.Sand Gas Oil Total Depth

PRODUCTION

1st 24 hrs. Nat. 1st 24 hrs. after shot Gas Cu. Ft.Dry Hole Abandoned

Date


OCT 1 8 1944 19S. J. LEWIS

Scout

Pool Name WildcatMap No. 73 Sec. 35 Twp. 16 R. 14WWell No. 1 LoganMcGuire Ind. CompanyABANDONED Contractor

SE NW NW

SECTION PLAT

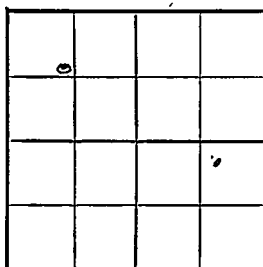990 Ft. from N. Line Ft. from S. Line Ft. from E. Line990 Ft. from W. LineBartonLocation Rig up

Drilling and Remarks:

*Conq 3409**3474 in Conq*

RECORD

Cased in., ft.Sand Gas Oil Total Depth 3474

PRODUCTION

1st 24 hrs. Nat. 1st 24 hrs. after shot Gas Cu. Ft.Dry Hole Abandoned

Date

DEC 6 1944 19 S. J. LEWIS Scout