

# KANSAS


Barton

FORM 51 5M 1-42 PETROL

Section 36 Township 16 Range 14-W

Well No. #1 Adie

Company Phillips

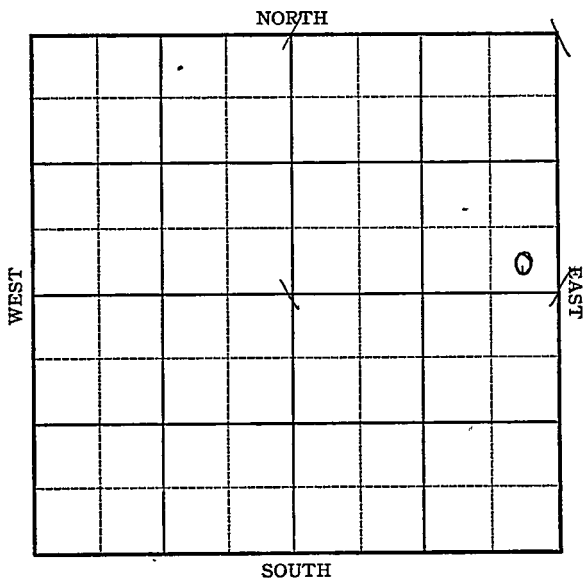

**KANSAS**

Barton

Sec. 36 Twp. 16 R. 14-W

Well No. #1 Adie Farm

Phillips Company

Barrett


         Ft. from N. Line

330 Ft. from S. Line

330' Ft. from E. Line

         Ft. from W. Line

*Elev. 1978*

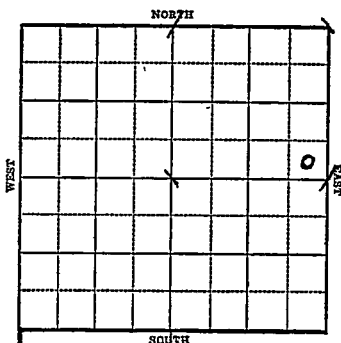

1943

R E P O R T

5/12	Location.
5/19	"
5/26	"
6/2	8" @ 614' Drlg. 2624'
6/9	Drlg. 2970'
6/16	Lans 3227 Arb. 3429-36 T.D. 5" @ 3429' RUST
6/23	T.D. 3451' Swab $1\frac{1}{2}$ oil per hr.
6/30	" "
7/7	" "
7/14	" "
7/21	" "
7/28	" "
8/4	" "
8/18	" "
8/25	" "
9/1	" "

**OVER**

1943

9/8

Aro 3429

5" @ 3429

500 acid

Pump 13 oil & 13 water Pot.

T.D. 3460'

Gravity 36

**COMPLETED**

KANSAS

Map No. 73 Sec. 36 Twp. 16 R. 14WWell No. 1 Adie

Phillips

Company

FIRST REPORT

Contractor

SE NE

## SECTION PLAT

         Ft. from N. Line330 Ft. from S. Line330 Ft. from E. Line         Ft. from W. Line


BARRETT POOL

Location XXXXRig up         

Drilling and Remarks:

## RECORD

Cased          in.,          ft.Sand         Gas         Oil         Total Depth         

## PRODUCTION

1st 24 hrs. Nat.         1st 24 hrs. after shot         Gas          Cu. Ft.Dry Hole         Abandoned         

Date

MAY 1 2 1943 19

S. J. LEWIS

Scout

**KANSAS**

Map No. 73 Sec. 36 Twp. 16 R. 14W

Well No. 1 Adie

**Phillips** Company

**COMPLETED** Contractor

**SE NE**

**SECTION PLAT**

\_\_\_\_\_ Ft. from N. Line

330 Ft. from S. Line

330 Ft. from E. Line

\_\_\_\_\_ Ft. from W. Line

			b

**BARRETT POOL**

Location \_\_\_\_\_

Rig up \_\_\_\_\_

Drilling and Remarks:

*Cor #3429  
5" C 3429  
500 acid*

*Pump 130' L + 13' Water  
P. F.*

*360 gal*

**RECORD**

Cased \_\_\_\_\_ in., \_\_\_\_\_ ft.

Sand \_\_\_\_\_

Gas \_\_\_\_\_

Oil \_\_\_\_\_

Total Depth 3460

**PRODUCTION**

1st 24 hrs. Nat. \_\_\_\_\_

1st 24 hrs. after shot \_\_\_\_\_

Gas \_\_\_\_\_ Cu. Ft.

Dry Hole \_\_\_\_\_

Abandoned \_\_\_\_\_

Date

SEP 8 1943 19

S. J. LEWIS Scout