Barton


FORM 51

KANSAS

Section 34 Township 16 Range 14W

Well No. #1 Kingston

Company J.J. Lynn

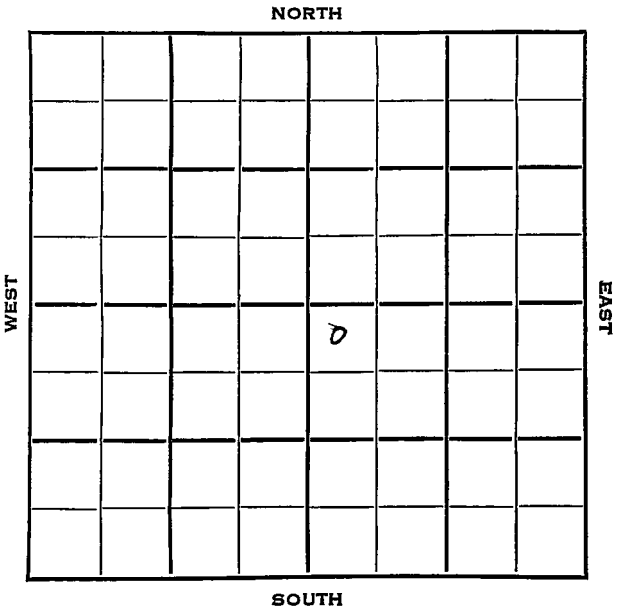

Barton KANSAS

SEC.	TWP.	R.
34	16	14W

WELL NO.
1 Kingston FARM

COMPANY
J. J. Lynn

CONTRACTOR
Sterling Drlg.

Wildcat


330 Ft. from N. Line

Ft. from S. Line

Ft. from E. Line

330 Ft. from W. Line

NW NW SE

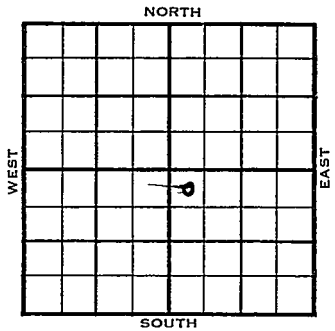

1954	ELEVATION 1985' REPORT
3/17	Spud 3-12-54 8" @ 310' Anhy 955' Drlg. 1637'
3/24	Heeb 3144', Doug 3169', Lans 3212', Cong 3431', Wea Arb. 3452', Arb. 3477' DST 3478-85', 1/2 hrs., 25' M, 520# DST 3481-90', 1/2 hrs., 20' M 855#
3/31	Spud 3-12-54 D &A TD 3505' 8" @ 310' Anhy 955', Heeb 3144', Doug 3169' Lans 3212', Cong 3431', Weathered Arb. 3452', Arb 3477' DST 3478-85' opn ½ hr, rec 25' Mud 520# DST 3481'-90' opn ½ hr, rec 20' Mud 855# TD 3505' D &A

ABANDONED

DX-78

FORM 275 FOR SALE BY KANSAS BLUE PRINT CO.


County Barton State Kansas

Sec. 34 (Blk. Twp.) 16 (Sur. Rge.) 14W Map No.

Operator J. J. Lynn

Well No. 1 Farm Kingston

Elev. Location NW NW SE

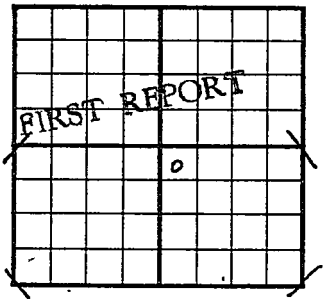

330 Ft. From N Line SE

330 Ft. From W Line Quarter

1st. Report MAR 17 1954

Completion

Remarks Sterling Drlg. - Contr.

Spudding Date 3-12-54

Drlg. Data Wildcat

8" @ 310 Anhy 955 drlg. 1637

J. G. McGEHEE

FORM 275 FOR SALE BY KANSAS BLUE PRINT CO.


County Barton State Kansas

Sec. 34 (Blk. Twp.) 16 (Sur. Rge.) 14W Map No.

Operator J. J. Lynn

Well No. 1 Farm Kingston

Elev. 1985 Location NW NW SE

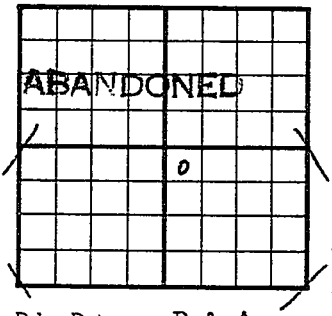

330 Ft. From N Line SE

330 Ft. From W Line Quarter

1st. Report

Completion MAR 31 1954

Remarks Wildcat

Sterling Drlg. - Contr.

Spudding Date 3-12-54

Drlg. Data D & A TD 3505

8" @ 310 Anhy 955 Heeb. 3144

Doug. 3169 Lans. 3212 Cong. 3431

Weathered Arb. 3452 Arb. 3477 DST 3478-85

open ½ hr. Rec. 25' mud 520#

DST 3481-90 open ½ hr. Rec. 20' mud

855# TD 3505

D & A

J. G. McGEHEE