
FORM 51 25M 8-50 WESTERN Barton KANSAS

Section 36 Township 16 Range 14 W

Well No. # 3 Fleming

Company Anschutz

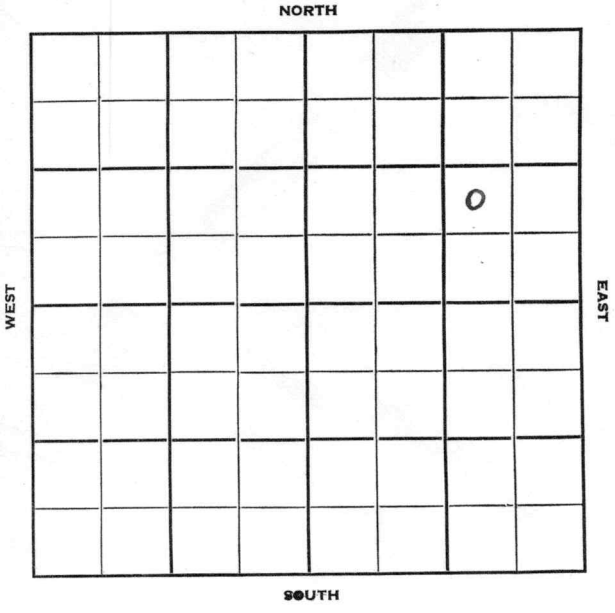

FORM 252-B
10M 10-50 PETROL

Barton

KANSAS

Sec. 36 Twp. 16 R. 14W

Well No. #3 Fleming Farm

Anshutz Company

Contractor


Ft. from N. Line

990 Ft. from S. Line

990 Ft. from E. Line

Ft. from W. Line

NW SE NE

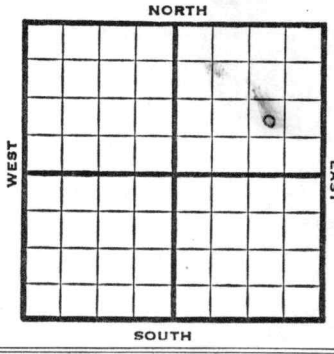

1952	Elev. 1977' REPORT
8/13	MIR
8/20	8" @ 216 Anhy 940' Drlg. 2690'
8/27	Heeb. 3135 Br Li 3210 (6 DST later) Cong 3429 Arb. 3467 RTD 3472 5" @ 3469
9/3	24/ 3417-23 1000 A
9/10	S/9 BOPH plus 5% wtr. Set plug 3400' 48/3383-91' Fill up 500' oil 25 mins S/7½ BOPH plus trace for 7 hrs.
9/17	NR
9/24	"
10/1	"
10/8	Spud 8-13-52 Oil Well TD 3472' 8" @ 216' Anhy 940 Heeb. 3135 Br Li 3210 DST 3233-50 open 7 5 min. rec. 1170' gas 30' sli. muddy oil 100' gassy oil 20' mud & wtr. 950# DST 3260-76 open 75 min. rec. 30' socm 50# DST 3270-90 open 75 min. rec. 75' O&GCM 130' oil 560' gas 900#

OVER

1952

10/8 DST 3308-15 open 1¼ hr. rec. 55' wtr. 950#
DST 3345-57 open 90 min. rec. 165' gas 15' oily mud 65' wtr. 285#
DST 3366-82 open 1 hr. rec. 1050' oil 800# Cong. 3429 Arb. 3467
TD 3472 5" @ 3469 24/ 3417-23 1000 A S/ 9 boph 5% wtr. SP 3400 48/ 3383-91 FU 500' oil 25 min. S/ 7½ boph Comp. 76 bopd 11% wtr.

COMPLETED

FORM 275 FOR SALE BY KANSAS BLUE PRINT CO.


County Barton State Kansas

Sec. 36 (Blk. Twp.) 16 (Sur. Rge.) 14W Map No.

Operator Anschutz

Well No. 3 Farm Fleming

Elev. Location NW SE NE

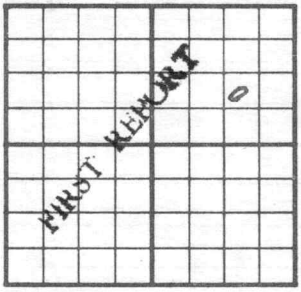

990 Ft. From S Line NE

990 Ft. From E Line Quarter

1st. Report AUG 13 1952

Completion

Remarks

Spudding Date

Drlg. Data

MIR

J. G. McGEHEE

FORM 275 FOR SALE BY KANSAS BLUE PRINT CO.


County Barton State Kansas

Sec. 36 (Blk. Twp.) 16 (Sur. Rge.) 14W Map No.

Operator Anschutz Drlg.

Well No. 3 Farm Fleming

Elev. 1977 Location NW SE NE

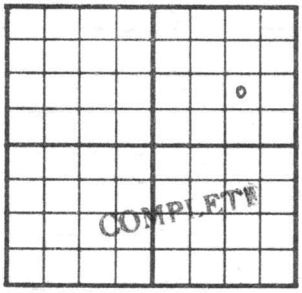

990 Ft. From S Line NE

990 Ft. From E Line Quarter

1st. Report

Completion OCT 8 1952

Remarks

Spudding Date 8-13-52

Drlg. Data Oil well TD 3472

8" @ 216 Anhy 940 Heeb. 3135

Br. lime 3210 DST 3233-50 open 75 min.

Rec. 1170' gas 30' sli. muddy oil

100' gassy oil 20' mud & wtr. 950#

DST 3260-76 open 75 min. Rec. 30' socm

50# DST 3270-90 open 75 min.

Rec. 75' o & gcm 130' oil 560' gas

900# DST 3308-15 open 1¼ hr. Rec. 55'

wtr. 950# DST 3345-57 open 90 min.

Rec. 165' gas 15' oily mud 65' wtr.

285# DST 3366-82 open 1 hr. Rec. 1050'

oil 800# Cong. 3429 Arb. 3467

TD 3472 5" @ 3469 24/ 3417-23 1000 A

S/ 9 boph 5% wtr. SP 3400 48/ 3383-91

J. G. McGEHEE

Drlg. Data

FU 500' oil 25 min. S/ 7⅛ bopd

Comp. 7.6 bopd 11% [illegible]

OCT 17 1952

