


Section 36 Township 16 Range 14W

Well No. #2 Fleming "A"

Company Anschutz Drlg.

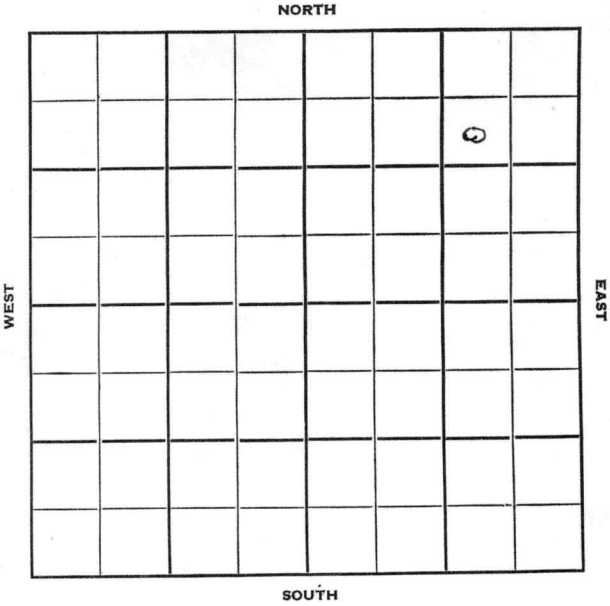

Barton

KANSAS
14W

Sec. 36 Twp. 16 R.

Well No. #2 Fleming "A" Farm

Anschutz Drlg. Company

Contractor


990 Ft. from N. Line

 Ft. from S. Line

990 Ft. from E. Line

 Ft. from W. Line

SW NE NE

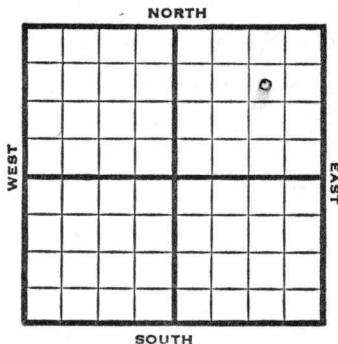

1952 Elev. 1974' REPORT

- 9/47 Spud 8-27-52
8" @ 233'
Anhy 940'
Drlg. 3060'
- 9/10 DST in Topeka 3071-87, 1 hr, 7' M
980# Heeb 3131' Br li 3206'
Lans. 3216'
DST 3219-45, 2 hrs, 300' gas plus 15'
oil, 10' O & GCM 1000#
DST 3341-52, 1 hr, 160' wtr, 970#
DST 3361-81, 2 hrs, 35' M 180#
DST 3383-3400, 1½ hr, 160' wtr, 970#
DST 3398-3416, 1/2 hr, 5' M 0#
Arb. 3444 5" @ 3446 RTD 3448'
- 9/17 44/3410-18 500 A 1½ BFPH PB 3405
20/3382-87 500 A S/4 BWPH PB 3383
60/3370-80 S/2½ BWPH PB 3364
To perf.
- 9/24 48/3350-58 wtr. Sq 3341-3405 CO 3381
54/3370-80 SO & W 500 A 4½ BWPH
PB 3364 4½ BWPH PB 3291'
24/3281-87 500 A 1¼ BOPH 1500 A

OVER

1952

10/1

PB 3279' 24/3272-78' NS 500 A
PB 3267' 16/3258-62 500 A
1-1/3 BOPH PB 3252' 24/3243-49
500 A 1.7 BOPH drove plugs 3289'
Sq off.

10/8

48/3282-90, 1000A, testing

10/15

P 41 BOPD

10/22

Spud 8-27-52

Oil Well

TD 3448'

8" @ 233'

Anhy 940'

DST 3071-87 opn 1 hr., rec. 7' mud
980#

Heeb 3131', Br. Lime 3206', Lans
3216'

DST 3219-45, opn 2 hr., rec. 300'
gas 15' oil 10' o & gcm 1000#

DST 3341-52 opn 1 hr., rec. 160'
wtr 970#

DST 3361-81, opn 2 hr., rec. 35' mud
180#

DST 3383-3400', opn 1 1/2 hr., rec. 160'
wtr 970#

DST 3398-3416 opn 1/2 hr., rec. 5' mud
0#

Arb. 3444'

5" @ 3446'

TD 3448'

44/3410-18, 500A 1 1/2 bfph

PB 3405', sp/3382-87 500A S/4 bwph

PB 3383 60/3370-80, S/2 1/2 bwph

PB 3364 48/3350-58 wtr. sq off

3341-3405 CO to 3381 54/3370-80

1 qt. oil 2 qt wtr ph 500A 4 1/2 bwph

PB 3364 4 1/2 bwph PB 3291 24/3281-87

500A 1 1/2 boph 1500A S/1 3/4 boph

3% wtr - PB 3279 24/3272-78 500A

PB 3267 16/3272-78 500A PB 3267

16/3258-62 500A S/ 1-1/3 boph S/1-

3/4 boph S/2 3/4 boph 10% wtr.

PB 3252 24/3243-49, 500A, S/1.7

boph DP 3289 S/ 3/4 bfph 43/3282-90

1000A S/ 1 boph 3% wtr.

Comp. 101 bopd 20% wtr.

COMPLETED

Drig. Data

wtr. sq off 3341-3405 CO to 3381
54/ 3370-80 1 qt. oil 2 qt wtr ph
500 A 4½ bwph - PB 3364 4½ bwph
PB 3291 24/ 3281-87 500 A 1½ boph
1500 A S/ 1 3/4 boph 3% wtr. PB 3279
24/ 3272-78 500 A PB 3267 16/ 3272-78
500 A PB 3267 16/ 3258-62 500 A
S/ 1 1/3 boph S/ 1 3/4 boph S/ 2 3/4
boph 10% wtr. PB 3252 24/ 3243-49
500 A S/ 1.7 boph DP 3289 S/ 3/4 boph
48/ 3282-90 1000 A S/ 1 boph 3% wtr.
Comp. 101 bopd 20% wtr.

Scout Cards
Land Small Map
Land Wall Map
Tracings
France Map
France Map
Misc.

D.P.

OCT 29 1952