

Section 18 Township 14 Range 13 W

Well No. # 2 Rein "B"


Company Murfin Drlg.

NORTH

14

WEST

EAST

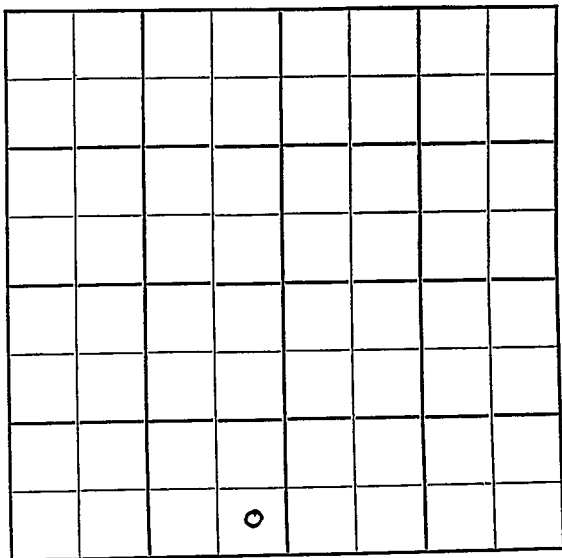

SOUTH

Russell

KANSAS

Sec. 18 Twp. 14 R. 13 W

Well No. # 2 Rein "B" Farm

Murfin Drlg. Company

Contractor


\_\_\_\_\_ Ft. from N. Line

330 Ft. from S. Line

330 Ft. from E. Line

\_\_\_\_\_ Ft. from W. Line

SE SE SW

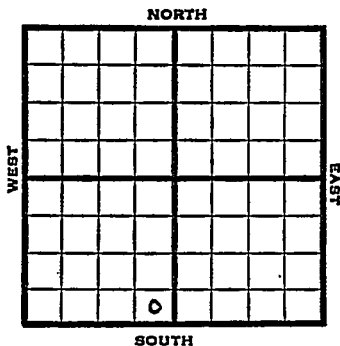

1951

Elev. 1802'

REPORT

2/14

MIM

4/4

Spud 2-19-51

Oil well TD 2360'

12" @ 305' 10" @ 439' Anhy 763'

8" @ 770' Tarkio 2324-30'

Pay 2335-54' TD 2360' 7" @ 2338'

S/ 23 GOPH Hydrofrac S/ 6 BOPH

for 3 days

Comp. 35 BOPD

**COMPLETED**



