


Section 18 Township 14 Range .13W

Well No. 5^{cm} - Rein "B"

Company Murfin Drlg

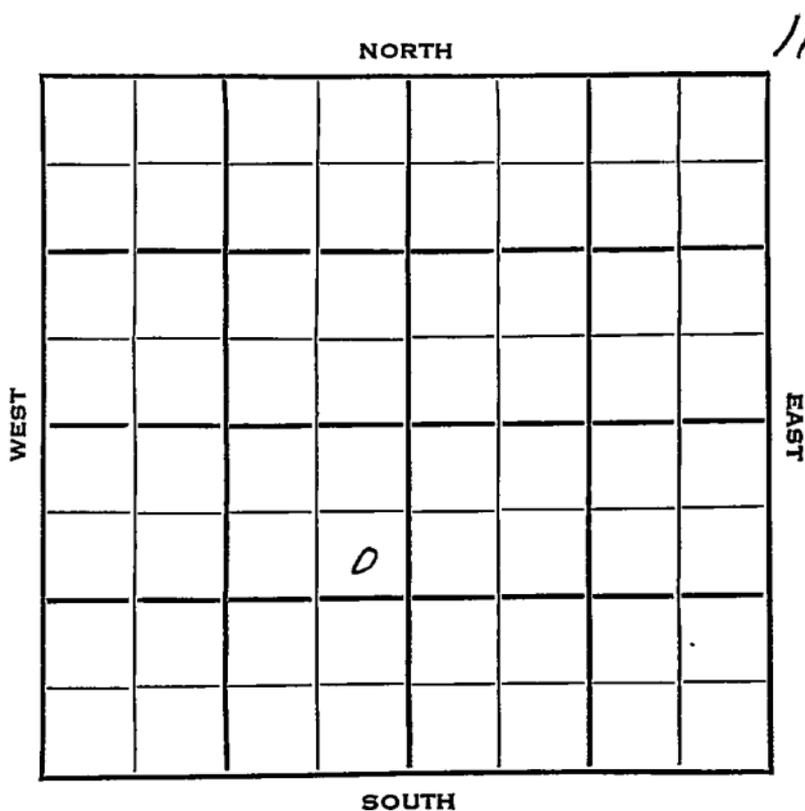

Sec. 18 Twp. 14 R. 13 W

Well No. # 5 Rein "B" Farm _____

Murfin Drlg. Company _____

Murfin Drlg. Contractor _____


990 Ft. from N. Line

_____ Ft. from S. Line

330 Ft. from E. Line

_____ Ft. from W. Line

SE NE SW

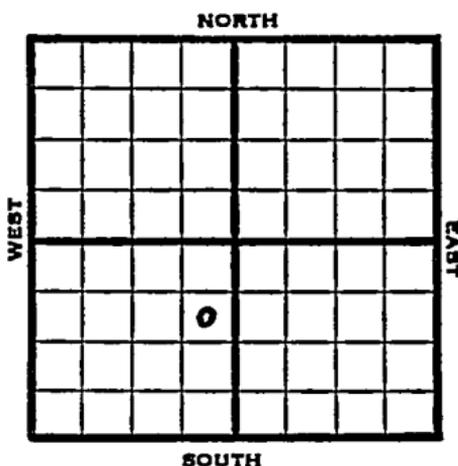

1952

Elev. 1796' REPORT

12/30

Location

1/1

Location

1/8

Spudding 1/5/53

1/22

Drlg. 2145'

1/29

1st Tarkio 2321, 2nd Tarkio 2342

TD 2350

5" @ 2342

2/4

Spud 1-5-53 Oil well TD 2350

15" @ 21 12" @ 345 10" @ 466

Anhy 768 8" @ 776 Tarkio 2321+

2nd Tarkio 2342+ TD 2350

5" @ 2342 CO to 2350 Sd-frac.

S/114 BO 8 hr.

Comp. 30 BOPD

COMPLETED

