



Sec. 18 Twp. 14 R. 13W

Well No. #7 Rein "B" Farm

Murfin Drlg. Company

Murfin Drlg. - Contr. Contractor


Ft. from N. Line

990 Ft. from S. Line

Ft. from E. Line

990 Ft. from W. Line

NE SW SW

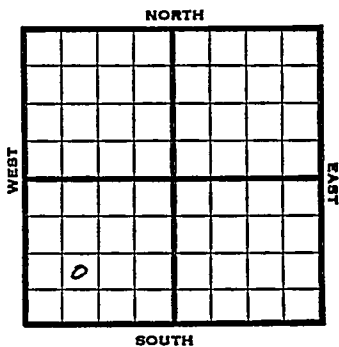

1953 Elev. 1785' REPORT

- 3/4 RUR
- 3/12 NR
- 3/19 NR
- 3/26 NR
- 4/2 "
- 4/9 "
- 4/16 NR
- 4/23 13" @ 289'
- 10" @ 429
- Anhy 748'
- 8" @ 754
- 4/30 Drlg. 1775'
- 5/7 TD 2337 Tarkio 2329 7" @ 2329 1/2
- 5/20 Spud 4-14-53
- Oil well TD 2337 13" @ 289'
- 10" @ 429 Anhy 748 8" @ 754
- TD 2337 Tarkio 2310 2nd Tarkio 2329
- 7" @ 2329 DD 2337 S/20 BOPH st-frac.
- S/8 BOPH
- Comp. 50 BOPD

COMPLETED



