

KANSAS


Russell

FORM 51 5M 1-42 PETROL

Section 30 Township 14 Range 12-W

Well No. #2 Marsh "B"

Company Cities Service Oil

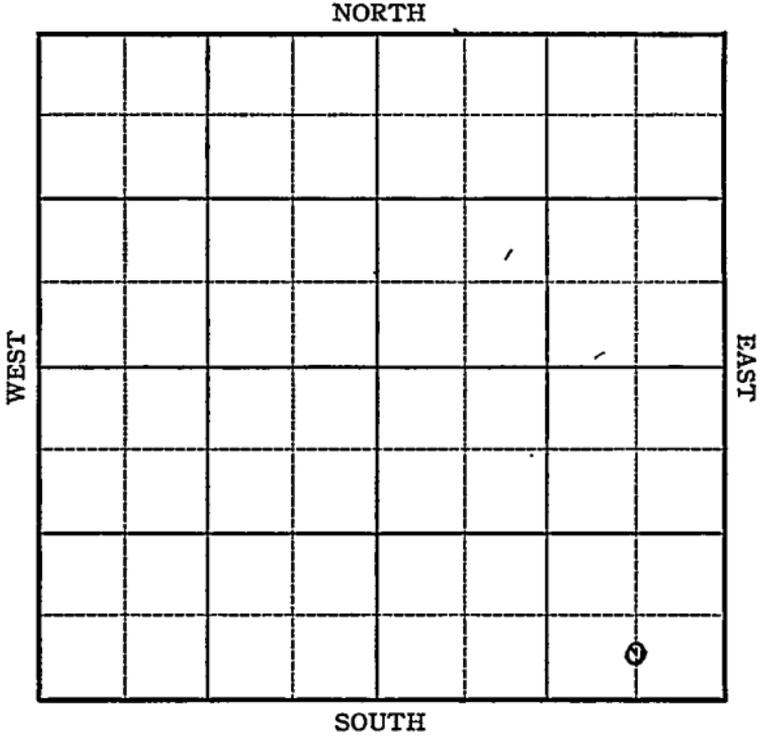

KANSAS Russell

Sec. 30 Twp. 14 R. 12-W

Well No. #2 Marsh "B" Farm

Cities Service Oil Company

Greenvale


_____ Ft. from N. Line

330 Ft. from S. Line

660 Ft. from E. Line

_____ Ft. from W. Line

Elev. 1663

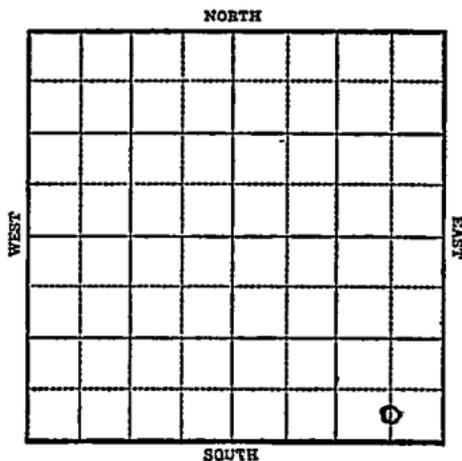

1943

R E P O R T

5/22 Location.

5/19 "

5/26 "

6/2 Drlg. 3066

6/9 Topeka 2502
Lans 2811
Gorhan 3104-05 T.D.
5" @ 3104 RUST.

6/16 " " "

6/23 Gorham 3104
5" @ 3104'
T.D. 3108'
Echo Pot. 1046'
Gravity 38.5

COMPLETED

KANSAS Russell

Map No. 56 Sec. 30 Twp. 14 R. 12W

Well No. 2 Marsh "B"

Cities Service Oil Company

FIRST REPORT Contractor

C SL SE SE

SECTION PLAT

			o

_____ Ft. from N. Line

330 Ft. from S. Line

660 Ft. from E. Line

_____ Ft. from W. Line

GREENVALE POOL

Location XXX

Rig up _____

Drilling and Remarks:

RECORD

Cased _____ in., _____ ft.

Sand _____

Gas _____

Oil _____

Total Depth _____

PRODUCTION

1st 24 hrs. Nat. _____

1st 24 hrs. after shot _____

Gas _____ Cu. Ft.

Dry Hole _____

Abandoned _____

Date

MAY 12 1943 19

S. J. LEWIS Scout

Russell

KANSAS

Map No. 56 Sec. 30 Twp. 14 R. 12W

Well No. 2 Marsh "B"

Cities Service Oil Company

COMPLETED Contractor

C SL SE SE

SECTION PLAT

_____ Ft. from N. Line

330 Ft. from S. Line

660 Ft. from E. Line

_____ Ft. from W. Line

GREENVALE POOL

Location _____

Rig up _____

Drilling and Remarks:

Sprham 3104

5" @ 3104

Echler 31046

385 ft

RECORD

Cased _____ in., _____ ft.

Sand _____

Gas _____

Oil _____

Total Depth 3105

PRODUCTION

1st 24 hrs. Nat. _____

1st 24 hrs. after shot _____

Gas _____ Cu. Ft.

Dry Hole _____

Abandoned _____

Date

JUN 23 1943

19

S. J. LEWIS Scout