KANSAS

FORM 51 5M 1-42 PETROL

Russell

Section 30, Township 14 Range 12-W

Well No. #3 Marsh "B"

Company Cities Service Oil

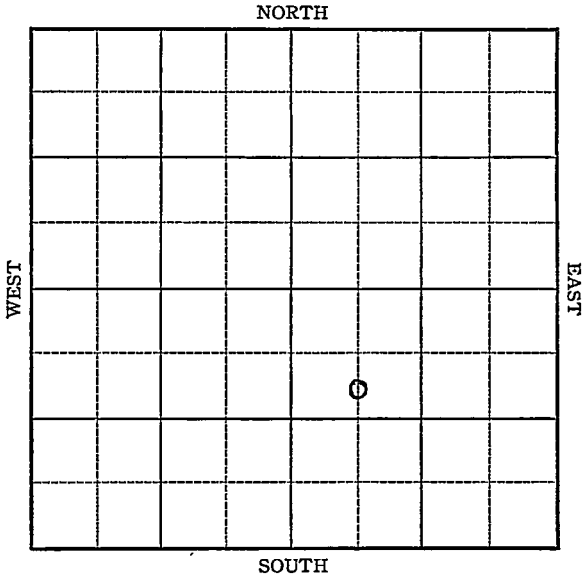

FORM 252-A
5M 9-42 GASS

KANSAS

Russell

Sec. 30 Twp. 14 R. 12-W

Well No. #3 Marsh "B" Farm

Cities Service Oil Company

Greenvale

990 Ft. from N. Line

_____ Ft. from S. Line

_____ Ft. from E. Line

660 Ft. from W. Line

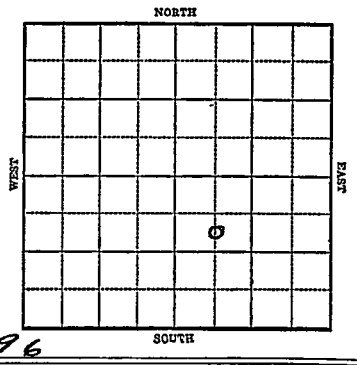

Elev. 1696

1943	REPORT
6/9	Rotary
6/16	8" @ 320 Drlg. 2505'
6/23	Lans 2844 Arb 3203-51 T.D. 5" @ 2996 Rust
6/30	9 shots yo 2942-50 no show 20 shots 2877-84 SO 34 shots 2861-69 SO & W 80' oil 1100' water in 36 hrs.
7/7	2009 acid pump 32 oil & 376 wate in 24 hrs.
7/15	PB 2800 in Topeka 8 shots 2723-31-350' water 9 " 2727-31 Water
7/21	Arb. 3203 5" @ 2996' T.D. 3251'
	ABANDONED

Form 26 200 Bks 5-42 Petrol

KANSAS Russell

Map No. 5-6 Sec. 30 Twp. 14 R. 12W

Well No. 3 Marsh "B"

Cities Service Oil Company

FIRST REPORT Contractor

C SL NW SE

990 Ft. from N. Line

Ft. from S. Line

Ft. from E. Line

660 Ft. from W. Line

GREENVALE POOL

SECTION PLAT

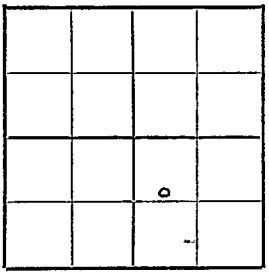

Location

Rig up

Drilling and Remarks:

Rotary

RECORD

Cased in., ft.

Sand

Gas

Oil

Total Depth

PRODUCTION

1st 24 hrs. Nat.

1st 24 hrs. after shot

Gas Cu. Ft.

Dry Hole

Abandoned

Date

JUN 9 1943 19 S. J. LEWIS Scout

Form 26 200 Bks 5-42 Petrol **Russell**

KANSAS

Map No. 7 Sec. 30 Twp. 14 R. 12W

Well No. 3 Marsh "B"

Cities Service Oil Company

ABANDONED Contractor

C S L NW SE

990 Ft. from N. Line

____ Ft. from S. Line

____ Ft. from E. Line

660 Ft. from W. Line

GREENVALE POOL

SECTION PLAT

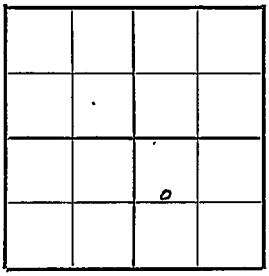

Location ____

Rig up ____

Drilling and Remarks:

RR Y 3203

5"@2996

RECORD

Cased ____ in., ____ ft.

Sand ____

Gas ____

Oil ____

Total Depth 8265

PRODUCTION

1st 24 hrs. Nat. ____

1st 24 hrs. after shot ____

Gas ____ Cu. Ft.

Dry Hole ____

Abandoned ____

Date

JUL 21 1943 19

S. J. LEWIS Scout