
Russell KANSAS

DX 78-1

Section 31 Township 14 Range 12W

Well No. 7 ~~6 Hupfer~~

Company Jones Shelburne & Farmer

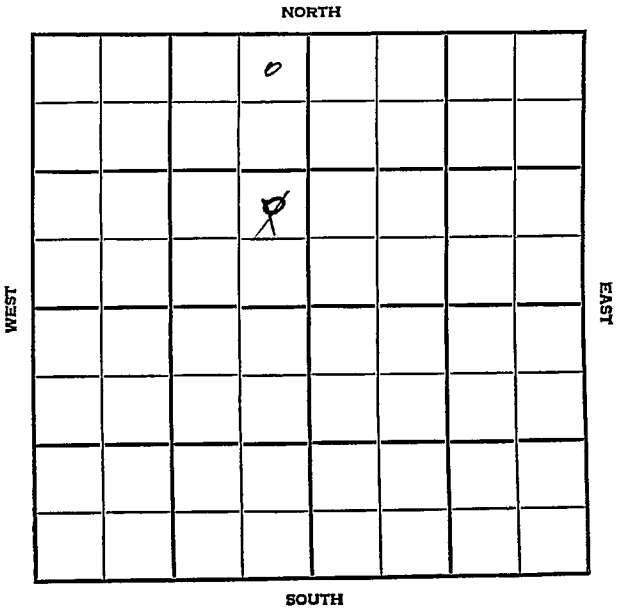

Russell KANSAS

SEC.	TWP.	R.
31	14	12W

WELL NO. #7

~~6~~ Hupfer FARM

COMPANY

Jones, Shelburne & Farmer

CONTRACTOR

J-S-F

Hall-Gurney Pool


330 Ft. from N. Line

~~990~~ Ft. from S. Line

330 Ft. from E. Line

Ft. from W. Line

NE ~~SE~~ NW

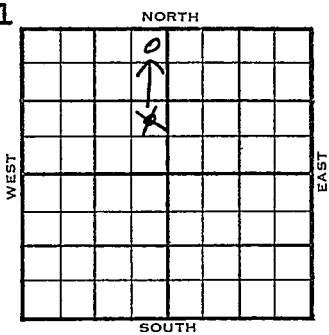

1954	ELEVATION 1665' REPORT
6/23	Spdg 6-15-54 Anhy 559 13" @ 604 Drlg. 610
6/30	Drlg. 1500'
7/7	10" @ 1885' Drlg. 2045'
7/21	Dodge 2755' Lans 2812 Drlg. 2860'
8/25	Spud 6-15-54 Oil Well TD 3118' Anhy 559' 13" @ 604' 10" @ 1885' Tarkio 2165' 8" @ 2225' Dodge 2755' Lans 2812', Gorham 3111' TD 3116' 5" @ 3113' CO to 3116 Sd-oil-frac 5 goph DD 3118 FU 1200' oil 10% wtr. 8 hrs., S/35 boph Comp. 25 bopd 10% wtr.

DX-78

COMPLETED

FORM 275 FOR SALE BY KANSAS BLUE PRINT CO.


County Russell State Kansas

Sec. 31 (Blk. Twp.) 14 (Sur. Rge.) 12W Map No.

Operator Jones, Shelburne & Farmer

Well No. 6 Farm Hupfer

Elev. Location NE SE NW

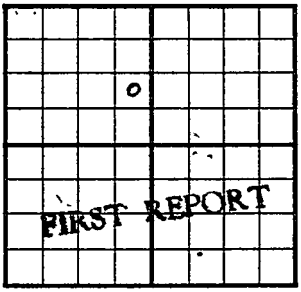

990 Ft. From S Line NW

330 Ft. From E Line Quarter

1st. Report JUN 23 1954

Completion

Remarks

J-S-F - Contr.

Spudding Date 6-15-54

Drlg. Data Hall-Gurney Pool

Anhy 559 13" @ 604 drlg. 610

J. G. McGEHEE

FORM 26 200 BKS. 4-52 PETROL

Kansas

Map No. _____ Sec. 31 Twp. 14 R. 12W


Well No. 7 Hupfer

Jones, Shelburne & Farmer Company

CORRECTION Contractor

NE NE NW

SECTION PLAT

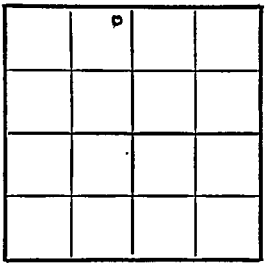

330 Ft. from N. Line

_____ Ft. from S. Line

330 Ft. from E. Line

_____ Ft. from W. Line

Russell County

Location _____

Rig up _____

Drilling and Remarks:

Reported
#6 Hupfer
NE SE NW

RECORD

Cased _____ in., _____ ft.

Sand _____

Gas _____

Oil _____

Total Depth _____

PRODUCTION

1st 24 hrs. Nat. _____

1st 24 hrs. after shot _____

Gas _____ Cu. Ft.

Dry Hole _____

Abandoned _____

Date

JUN 30 1954 19____

J. G. McGEHEE

_____ Scout

FORM 275 FOR SALE-BY KANSAS BLUE PRINT CO.


County Russell State Kansas

Sec. 31 (Blk. Twp.) 14 (Sur. Rge.) 12W Map No.

Operator Jones, Shelburne & Farmer

Well No. 7 Farm Hupfer

Elev. 1665 Location NE NE NW

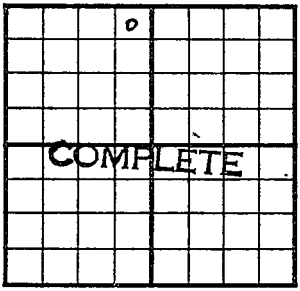

330 Ft. From N Line NW

330 Ft. From E Line Quarter

1st. Report

Completion AUG 25 1954

Remarks Hall-Gurney Pool

J-S-F - Contr.

Spudding Date 6-15-54

Drlg. Data Oil well TD 3118

Anhy 559 13" @ 604 10" @ 1885

Tarkio 2165 8" @ 2225 Dodge 2755

Lans. 2812 Groham 3111 TD 3116

5" @ 3113 CO to 3116 s-oil-frac

5 goph. DD 3118 FU 1200' oil 10% wtr.

8 hr. S/ 35 boph Comp. 225 bopd 10% wt

FABEN GUIDE