

Sec. 18 Twp. 14 R. 13W

Well No. #6 Rein"B" Farm

Murfin Drlg. Company

Murfin Drlg. Contractor

Hall-Gurney Pool


 Ft. from N. Line

990 Ft. from S. Line

330 Ft. from E. Line

 Ft. from W. Line

NE SE SW

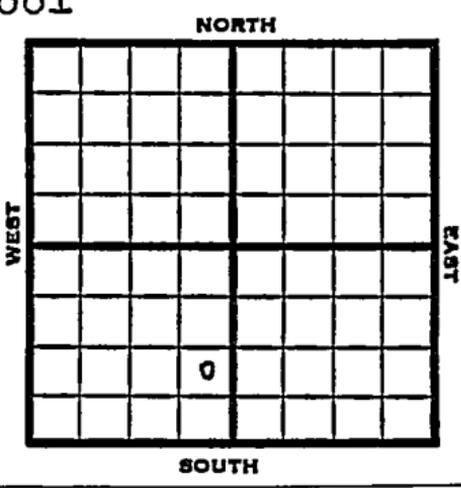

1953	Elev. 1803' REPORT
1/28	Cellar & Pits
2/5	"
2/12	12" @ 321'
2/19	10" @ 460 Anhy 780' Drlg. 1055'
2/26	Drlg. 1560'
3/12	1st Tarkio 2324' 2nd Tarkio 2343' TD 2351' .7" @ 2344 CO 2351'
3/18	Spud 2-7-53 Oil Well TD 2351 12" @ 321 10" @ 460 Anhy 780, 1st Tarkio 2324, 2nd Tarkio 2343 TD 2351 7" @ 2344 CO to 2351, sd-frac, Comp. 30 bopd -

COMPLETED

