


Section 18 Township 14 Range 13W

Well No. #1 Shaffer

Company Texas Co.

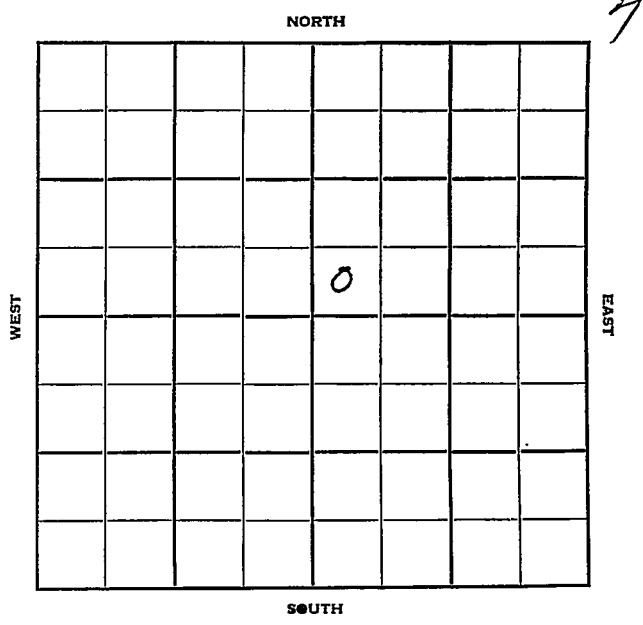

Russell

KANSAS

Sec. 18 Twp. 11 R. 13W

Well No. #1 Shaffer Farm

Texas Co. Company

Hall-Gurney Pool Contractor


Ft. from N. Line

330 Ft. from S. Line

Ft. from E. Line

330 Ft. from W. Line

SW SW NE

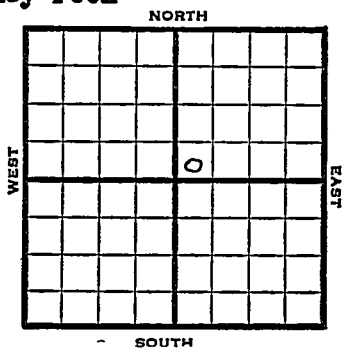

1952

Elev. 1804' REPORT

1/2
2/6
2/13

RUR
 POP
 Spud 12-31-51
 Oil Well TD 2342
 13" @ 380 10" @ 478 8" @ 615
 7" @ 2336 TD 2342 Hydro.
 S/ 2 boph Tarkio 2336
 Comp. 40 bopd

COMPLETED

