

KANSAS


FORM 51 5M 1-42 PETROL

Russell

Section 30 Township 14 Range 12-W

Well No. #3-Herd

Company Gulf

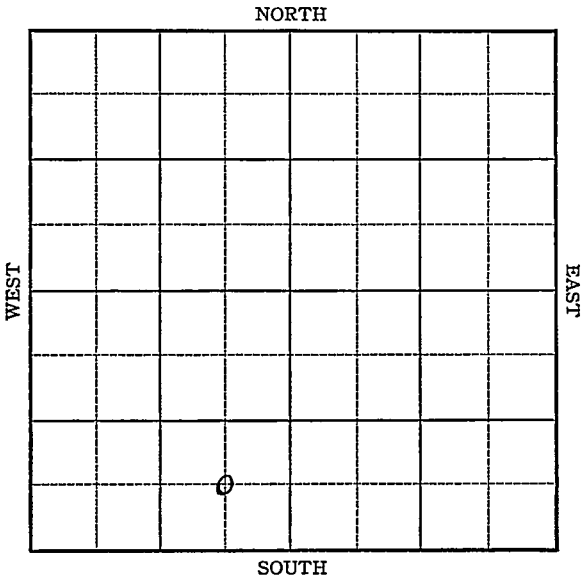

Sec. 30 Twp. 14 R. 12-^W

Well No. #3 Herd Farm

Gulf Company


Greenvale

_____ Ft. from N. Line

660 Ft. from S. Line

660 Ft. from E. Line

_____ Ft. from W. Line

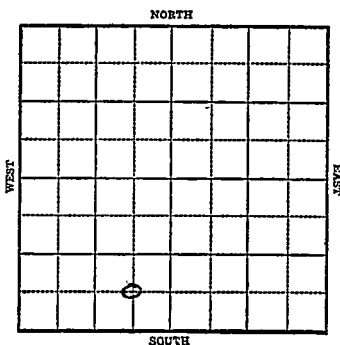

1943

R E P O R T

6/30 Rotary
7/7 8" @ 423
Drlg. 2675'
7/15 Cong. 3135
Arb 3153 SSO
T.D. 3163'
Run Csg.
7/21 5" @ 3155'
T.D. 3188
HFW.
P.B. 3145
WOC.
7/28 Lans 2847
Arb 3153
5" @ 3155
T.D. 3188'
P.B. 3124'
24 shots 2847-55.
2000 acid
Pump 308 Pot.
Gravity 39

COMPLETED

Russell

KANSAS

Map No. 34 Sec. 30 Twp. 14 R. 12W

Well No. 3 Herd

Gulf Company

FIRST REPORT Contractor

C SE SW

_____ Ft. from N. Line

660 Ft. from S. Line

660 Ft. from E. Line

_____ Ft. from W. Line

SECTION PLAT

	o		

GREENVALE POOL

Location _____

Rig up _____

Drilling and Remarks: _____

Rotary

RÉCORD

Cased _____ in., _____ ft.

Sand _____

Gas _____

Oil _____

Total Depth _____

PRODUCTION

1st 24 hrs. Nat. _____

1st 24 hrs. after shot _____

Gas _____ Cu. Ft.

Dry Hole _____

Abandoned _____

Date

JUN 3 0 1943 19

S. J. LEWIS Scout

Russell

KANSAS

Map No. 37 Sec. 30 Twp. 14 R. 12W

Well No. 3 Herd

Gulf Company

COMPLETED Contractor

C S E SW

SECTION PLAT

_____ Ft. from N. Line

660 Ft. from S. Line

660 Ft. from E. Line

_____ Ft. from W. Line

	o		

GREENVALE POOL

Location _____

Rig up _____

Drilling and Remarks:

*Lease 2847
 Act 3153
 5' @ 3155.
 PA 3124
 24c hr to 2847-55
 2000 acid
 Pump 308 P.Y.*

RECORD

Cased _____ in., _____ ft.

Sand _____

Gas _____

Oil _____

Total Depth 3188

PRODUCTION

1st 24 hrs. Nat. _____

1st 24 hrs. after shot _____

Gas _____ Cu. Ft.

Dry Hole _____

Abandoned _____

Date 39°/8

JUL 28 1943

19

S. J. LEWIS Scout