


SECTION 31 TOWNSHIP 13 RANGE 19W

WELL NO. #3 Riedel

COMPANY Musgrove

NORTH C W/2 W/2 SW/4 ~~of Sec.~~

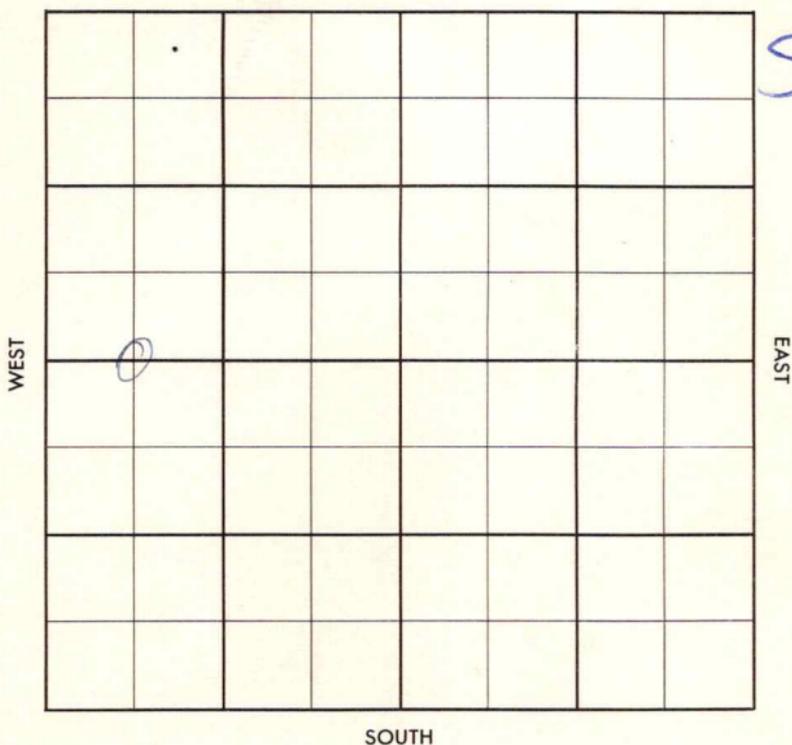

428855

FORM 513 SUNRAY

County Ellis Elev. _____
 Sec. 31 Twp. 13 Rge. 19W
 Company Misgrove
 Farm Name Riedel No. 3

TOPS	DEPTH	LOG	DATUM
Anh.			
Tr.			
H.			
Tr.			
Dg.			
B.L.			
L.			
K.C.			
B.K.C.			
Ce.			
C.			
M.			
M.			
K.			
Mz.			
Mq.			
V.			
S.			
S.			
A.			
R.			
Pf.			
G.			
T.D.			

Loc. in Sec. C W/2 W/2 of
Sec.
 Geol. _____
 Contr. _____
 Co. Tools _____
 Pool _____
 Pleasant No. _____

FIRST	REPORT
APR 10 1957	

Date Comm. 4-7-57
8" @ 242/150, Dirg. 1560

~~1A~~

CORRECTION

FORM 513 SUNRAY

County Ellis Elev. 2250
 Sec. 31 Twp. 13 Rge. 19W
 Company Musgrove
 Farm Name Riedel No. 3

TOPS	DEPTH	LOG	DATUM	Loc. in Sec.
Anh.				C W/2 W/2 of
TP.	3239			
H.	3798			SW 1/4
Tr.	3519			
Dg.				
Bl.				
L.	3540			Geol. _____
K.C.				Contr. _____
B.K.C.	3786			Co. Tools _____
Ce.				Pool _____
C.				Pleasant No. _____
M.				COMPLETE
M.				
K.				MAY 22 '57
Mz.				
Me.				
V.				
S.				
S.				
A	rework	3857		
R	ARC	3869		
PE.				
G.				
T.D.	3874			

Date Comm. 4-7-57

8" @ 242/150, Dirg. 1560 APR 17 '57

DST 3557-~~38~~²⁵ APR 24 '57 op. 1hr 1260'

9554 S.W BHP #30/25" 5 1/2

3870/150 MICT MAY 1 '57 CO DD

3876 \$ 4 Boph nolw 4 hrs

300 Acid \$ 4.7 Boph nolw

4 hrs DD 3880 TD 1/2 \$ 6

Boph nolw 6 hrs T & R MAY 8 '57

X wo pump unit MAY 15 '57 MAY 22 '57

Ph. P. 222 Bopd no/wite