


Section 31 Township 14 Range 12 W

Well No. # 9 J. M. Trapp

Company Magnolia Pet.

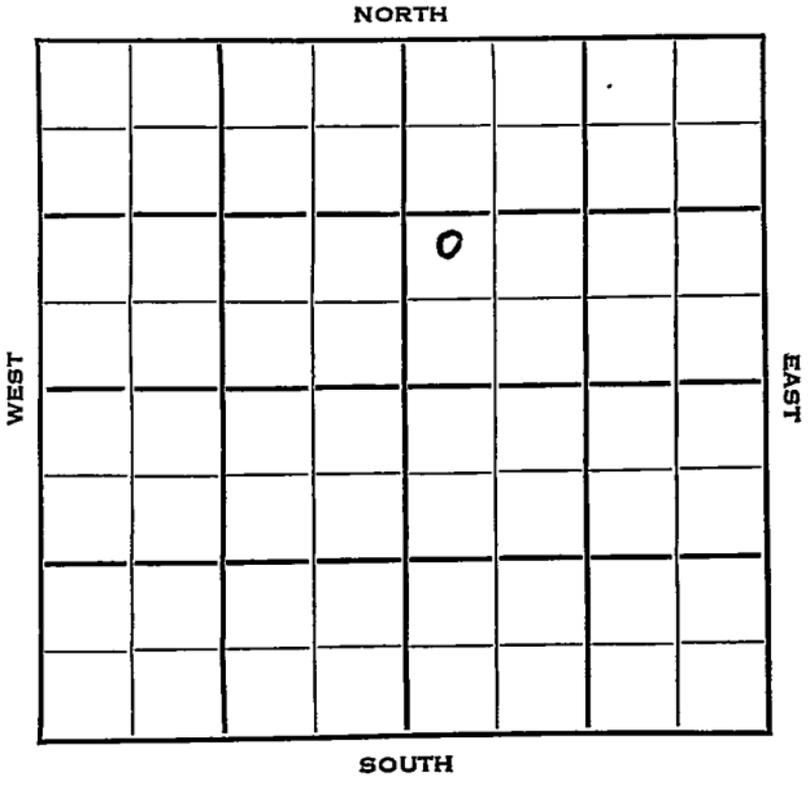

County Russell State Kansas

Sec. 31 (Blk.) 14 (Sur.) 12W Map No.

Operator Magnolia Pet.

Well No. 9 Farm J. M. Trapp

Elev. 1679 Location NW SW NE

		0			
COMPLETE					

1016 Ft. From S Line NE

330 Ft. From W Line Quarter

Ist. Report _____

Completion NOV 18 1953

Remarks _____

Barnett Drlg. - Contr.

Spudding Date 10-24-53

Drlg. Data Oil well TD 3207

9" @ 398 Heeb. 2746 Lans. 2826

DST 2864-70 open 1 hr. Rec. 450' gas

50' o & gcm 20' ho & gcm 440#

Gorham 3112 Arb. 3135 DST 3135-40

open 1 hr. Rec. 120' socm 240' sw

1025# TD 3207 6" @ 3206 CO to 3180

12/ 3111-14 FU 100' fluid 1 hr.

S/ 5 bo. 7 bwph 8 hr.

Comp. 25 bopd