


KANSAS

FORM 51 5M BR1X

Section 31 Township 14 Range 12W

Well No. #4 Pekarek

Company Skelly

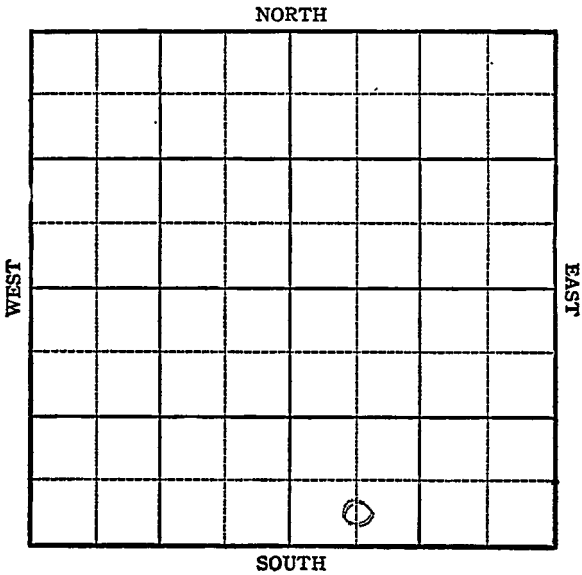

Sec. 31 Twp. 14 R. 12W

Well No. 4 Pekarek Farm

Skelly Company

Hall-Gurney


NORTH

 Ft. from N. Line

330 Ft. from S. Line

 Ft. from E. Line

660 Ft. from W. Line

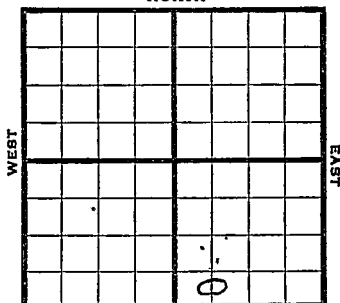

C S L SW SE

Elev. 1718

1944

R E P O R T

11/22	Location
11/29	RUR
12/6	Anhy 657
	8" @ 661'
	Drlg. 875'
12/14	Drlg. 1950'
12/21	Drlg. 2670
12/29	Drlg. 3020
	SD
1945	
1/3	Lans. 2878 ; SO 2912-16; 2919-27 3156-70; Arb 3175 TD 3178 SO 5" @ 3175 Rust
1/10	" " " "
1/17	" " " " " "
1/26	750 acid. Pump 10 oil plus 90 water in 15 hrs.
1/31	PB 3160'
2/7	48 shots to 3158-67 No shows 750 acid 15 gals oil PH 39 shots 3164-70 No sho Drill cement to 3171
2/14	1500 acid
2/21	" "
2/28	Plug 2930 - 72 shots 2910-18 SSO

OVER

1945

3/7 Lans 2878
 Arb 3175
 5" @ 3175
 PB 2930
 Perf. Lans 3000 acid
 TD 3178
 Pump 145 oil plus 5l water Pot.
- Grav. 38.0

COMPLETED

Pool Name Hall-GurneyMap No. 56 Sec. 31 Twp. 14 R. 12 WWell No. 4 PekarekSkelly CompanyFIRST REPORT ContractorC S L SW SE

SECTION PLAT

 Ft. from N. Line330 Ft. from S. Line Ft. from E. Line660 Ft. from W. Line

RussellLocation XRig up

Drilling and Remarks:

RECORD

Cased in., ft.Sand Gas Oil Total Depth

PRODUCTION

1st 24 hrs. Nat. 1st 24 hrs. after shot Gas Cu. Ft.Dry Hole Abandoned

Date

NOV 22 1944 19S. J. LEWIS Scout

Pool Name Hall-GurneyMap No. 56 Sec. 31 Twp. 14 R. 12WWell No. 4 PekarekSkelly CompanyCOMPLETED Contractor

C S L SW SE

SECTION PLAT

_____ Ft. from N. Line

330 Ft. from S. Line

_____ Ft. from E. Line

660 Ft. from W. Line

Russell County

Location _____

Rig up _____

Drilling and Remarks:

Lease 2878CR 831755" 03175PB 2980Perf Lease.3500 cu ftPump 145 oil +51 water 828Date 38⁰ 94

RECORD

Cased _____ in., _____ ft.

Sand _____

Gas _____

Oil _____

Total Depth 3128

PRODUCTION

1st 24 hrs. Nat. _____

1st 24 hrs. after shot _____

Gas _____ Cu. Ft.

Dry Hole _____

Abandoned _____

MAR 7 1945 19

S. J. LEWIS Scout