

KANSAS


Russell

Section 31 Township 14 Range 12W

Well No. 7 Pekarek

Company Skelly

Hall-Gurney
NORTH

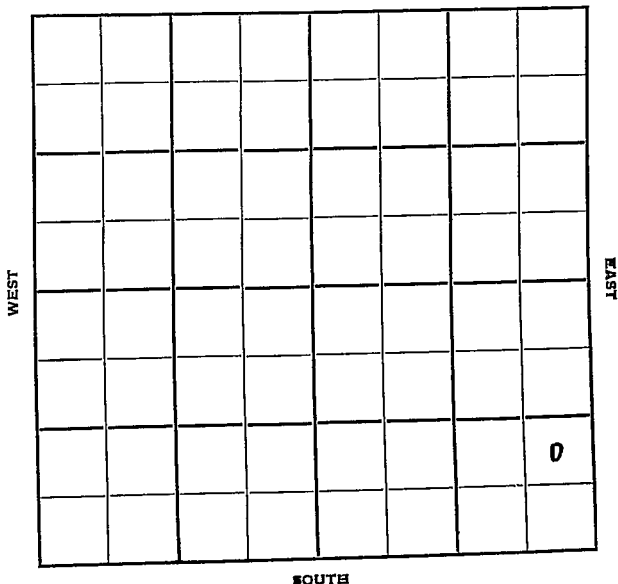

KANSAS

Russell
14 R.

12W ✓

Sec. 31 Twp. _____

Well No. #7 Pekarek Farm _____

Skelly Company _____

Hall-Gurney


_____ Ft. from N. Line

990' Ft. from S. Line

330' Ft. from E. Line

_____ Ft. from W. Line

NE SE SE

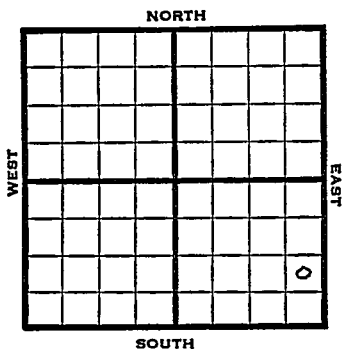

1949

Elev 1756' REPORT

4/27

Anhy 688'
8" @ 696
Drlg. 1400'

5/4

Lansing 2913'
Arb. 3205'
TD 3207

5" @ 3205'

5/10

"

5/18

Pump 204 bbls oil / 6W in 16 hrs.

5/25

"

6/1

TD 3207'
Arb. 3205'
5" @ 3205'
Pump 176 Oil / 8 W Pot
40⁹ Gr.

Comp

COMPLETEL

Map No. _____ Sec. 31 Twp. 14 R. 12W

Well No. 7 Pekarek

Skelly _____ Company

FIRST REPORT

Contractor

NE SE SE

SECTION PLAT

_____ Ft. from N. Line

990 Ft. from S. Line

330 Ft. from E. Line

_____ Ft. from W. Line

			o

Russell County

Location _____

Rig up _____

Drilling and Remarks:

Anhy 688

8" @ 696

dr1g. 1400

RECORD

Cased _____ in., _____ ft.

Sand _____

Gas _____

Oil _____

Total Depth _____

PRODUCTION

1st 24 hrs. Nat. _____

1st 24 hrs. after shot _____

Gas _____ Cu. Ft.

Dry Hole _____

Abandoned _____

Date

APR 27 1949 19

S. J. LEWIS Scout

