

KANSAS


Russell

FORM 51 5M 1-42 PETROL

Section 31 Township 14 Range 12-W

Well No. #4 Trapp

Company Magnolia

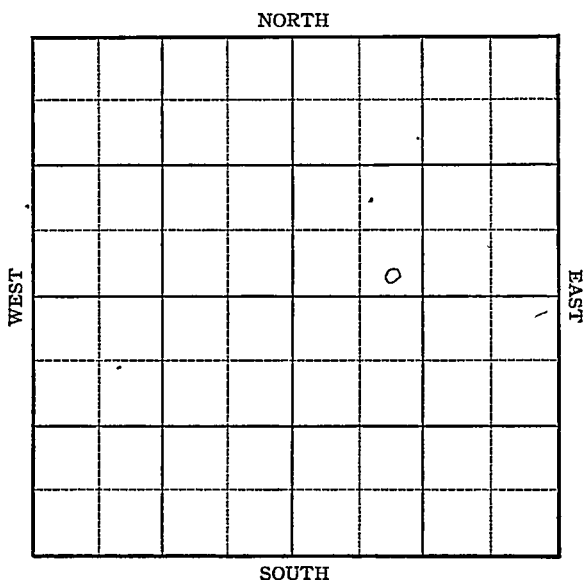

KANSAS

Russell

Sec. 31 Twp. 14 R. 12-W

Well No. #4 Trapp Farm

Magnolia Company

Greenvale


 Ft. from N. Line

330 Ft. from S. Line

 Ft. from E. Line

990 Ft. from W. Line

Elev. 1731

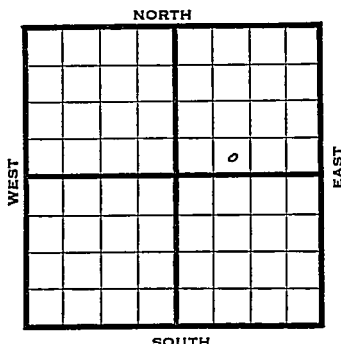

1943

REPORT

3/31 Rigging up rotary.

4/7 10" @ 344 WOC.

4/14 Drlg. 2390'

4/21 Gorhan 3172-75T.D. WOC.
7" @ 3172' RUST.

4/28 Gordan 3175 Corrected
7" @ 3175
T.D. 3179'
Pump 190 oilin 8 hrs.

5/5 Gorham 3175
7" @ 3175'
T.D. 3179'
Pump 418 Pot.
Gravity 38.5


COMPLETED

Russell

Map No. KANSAS Sec. 31 Twp. 14 R. 12WWell No. 4 TrappMagnolia CompanyFIRST REPORT Contractor

SE SW NE

SECTION PLAT

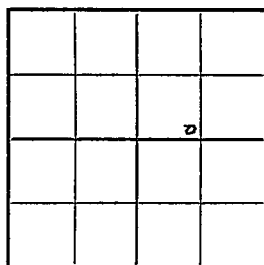 Ft. from N. Line330 Ft. from S. Line Ft. from E. Line990 Ft. from W. Line

GREENVALE POOL

Location Rig up

Drilling and Remarks:

Rigging up

Rotary

RECORD

Cased in., ft.Sand Gas Oil Total Depth

PRODUCTION

1st 24 hrs. Nat. 1st 24 hrs. after shot Gas Cu. Ft.Dry Hole Abandoned

Date

MAR 3 1 1943

19

S. J. LEWIS Scout

Russell

KANSAS

Map No. 36 Sec. 31 Twp. 14 R. 12WWell No. 4 Trapp

Magnolia Company

COMPLETED Contractor

SE SW NE

SECTION PLAT

		o	

Ft. from N. Line

330 Ft. from S. Line

Ft. from E. Line

990 Ft. from W. Line

GREENVALE POOL

Location

Rig up

Drilling and Remarks:

*Gorham 3175**2" @ 3175.**Pump 418 P.Y.**385 Gr*

RECORD

Cased _____ in., _____ ft.

Sand _____

Gas _____

Oil _____

Total Depth *3175*

PRODUCTION

1st 24 hrs. Nat. _____

1st 24 hrs. after shot _____

Gas _____ Cu. Ft.

Dry Hole _____

Abandoned _____

Date

MAY 5 1943 19

S. J. LEWIS

Scout