

Section 31 Township 14 Range 12W

Well No. #7 Trapp

Company Magnolia

Hall Gurney

NORTH

							0

WEST

EAST

SOUTH

KANSAS

Russell

Sec. 31 Twp. 14 R. 12W

Well No. #7 Trapp Farm _____

Magnolia Company _____


330 Ft. from N. Line

_____ Ft. from S. Line

330 Ft. from E. Line

_____ Ft. from W. Line

NE/c

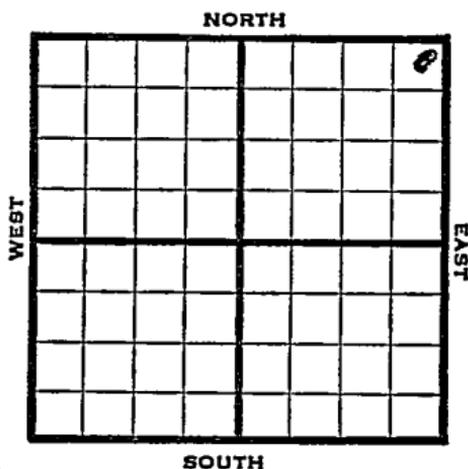

1947

Elev. 1679' REPORT

10/22

Location

10/29

"

11/5

10" @ 364'
Drlg. 2665'

11/12

Gorham 3123'
TD 3125'
5" @ 3123'
RUST

11/19

Gorham 3123'
5" @ 3123'
Pump 625 oil Pot -/ 18% W.
Gr. 40;9
TD 3128'

COMPLETED

Kansas

Hall Gurney

Map No. _____ Sec. 31 Twp. 14 R. 12WWell No. 7 TrappMagnolia

Company

FIRST REPORT

Contractor

NE/C

SECTION PLAT

330 Ft. from N. Line

_____ Ft. from S. Line

330 Ft. from E. Line

_____ Ft. from W. Line

Russell CountyLocation X

Rig up _____

Drilling and Remarks:

RECORD

Cased _____ in., _____ ft.

Sand _____

Gas _____

Oil _____

Total Depth _____

PRODUCTION

1st 24 hrs. Nat. _____

1st 24 hrs. after shot _____

Gas _____ Cu. Ft.

Dry Hole _____

Abandoned _____

Date

OCT 22 1947

19

S. J. LEWIS

Scout

Kansas

Map No. 56 Sec. 31 Twp. 14 R. 12W

Well No. 7 Trapp

Magnolia Company

COMPLETE

Contractor

NE/C

E11699

SECTION PLAT

330 Ft. from N. Line

 Ft. from S. Line

330 Ft. from E. Line

 Ft. from W. Line

			o

Russell County

Location

Rig up

Drilling and Remarks:

Goekam 8/23

5" @ 8/23

Pump. 625 oil

Pat + 18 2/3 W

40 2/3 W

RECORD

Cased in., ft.

Sand

Gas

Oil

Total Depth 8/28

PRODUCTION

1st 24 hrs. Nat.

1st 24 hrs. after shot

Gas Cu. Ft.

Dry Hole

Abandoned

Date

NOV 19 1947

S. I. LEWIS

Scout