

KANSAS

Russell County

FORM 51 5M PETROL

Section 32 Township 14 Range 12W

Well No. 3 Bediger

Company Jones & Shelbourne

NORTH

0							

SOUTH

WEST


EAST

Sec. 32 Twp. 14 R. 12WWell No. 3 Bediger FarmJones & Shelbourne Company

Hall-Gurney

 Ft. from N. Line330 Ft. from S. Line Ft. from E. Line330 Ft. from W. Line

SW/c Elev. 1790

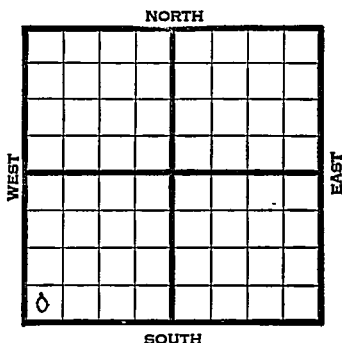

1945

REPORT

5/23	Location
5/31	"
6/8	"
6/14	Rig-
6/21	"
6/28	"
7/3	"
7/11	Shut down
7/19	" "
7/26	Drlg. 220
8/1	15" @ 411
	Anhy 617-622
	Run 12"
8/8	12" @ 722
	Drlg. 1592
8/15	10" @ 2000
	Drlg. 2185
8/22	Topeka 2645
	8" @ 2380
	Drlg. 2850'
8/29	Lans 2944
	7" @ 3029
	3043 UR 7" 1000' oil
9/5	3261 5" @ 3261 WOC
9/12	Gorham 3250-3261
	TD 3261
	5" @ 3119 corrected
	67 shots 3020-3046 4000 acid.
	850' oil
9/19	" " " "

OVER

1945

9/26 Gorham 3250-3261
TD 3261
5" @ 3119 corrected
67 shots 3020-3046 4000 acid.
850' oil

10/3 Gorham 3250
5" @ 3119
Lans. 2944
Perf. Lans 4000 acid.
TD 3261'
Pump 263 oil plus 36% Wtr.
Grav. 38.0

COMPLETED

Russell, Kansas Pool Name Hall-GurneyMap No. 56 Sec. 32 Twp. 14 R. 12WWell No. 3 BedigerJones & Shelbourne Company

FIRST REPORT

Contractor

SW/c

SECTION PLAT

 Ft. from N. Line330 Ft. from S. Line Ft. from E. Line330 Ft. from W. Line*Russell County*Location XRig up

Drilling and Remarks:

RECORD

Cased in., ft.Sand Gas Oil Total Depth

PRODUCTION

1st 24 hrs. Nat. 1st 24 hrs. after shot Gas Cu. Ft.Dry Hole Abandoned

Date

MAY 23 1945

19

S. J. LEWIS


Scout

KANSAS Kansas Pool Name Hall-GurneyMap No. 56 Sec 32 Twp. 14 R. 12WWell No. 3 BedigerJones & Shelbourne Company

COMPLETED

Contractor

SW/c

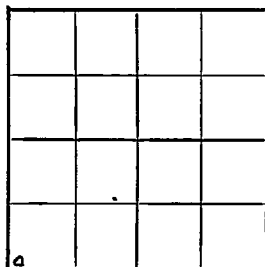E11790
SECTION PLAT Ft. from N. Line330 Ft. from S. Line Ft. from E. Line330 Ft. from W. Line

Russell County

Location Rig up

Drilling and Remarks:


RECORD

Cased in. ft.Sand Gas Oil Total Depth 3261

PRODUCTION

1st 24 hrs. Nat. 1st 24 hrs. after shot Gas Cu. Ft.Dry Hole Abandoned

OCT 3 1945 19

S. J. LEWIS Scout